

RIGHT SIDE VIEW FOR CONVERSION OF OUTBUILDING TO ANNEXE

AT 124 ST DUNSTONS DRIVE DA12 4BQ

18-10-2021.

SCALE 1:100 ON A4


5metres

DWG NO 1

NB. THERE ARE NO DIMENSIONAL OR STRUCTURAL CHANGES.

OR CHANGES TO EXTERNAL APPEARANCE AT ALL

EXISTING AS BUILT IN 2013

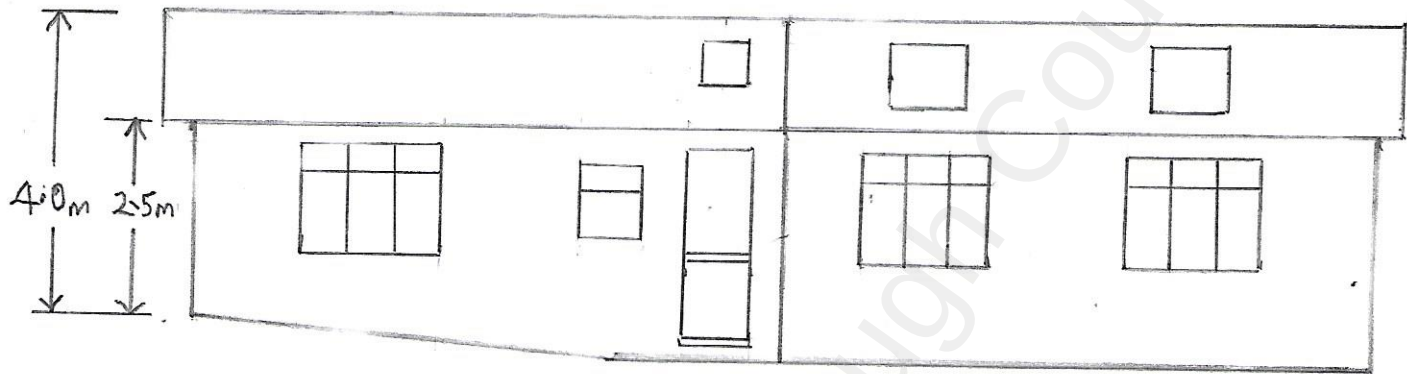

PROPOSED (NO CHANGE AT ALL)

