
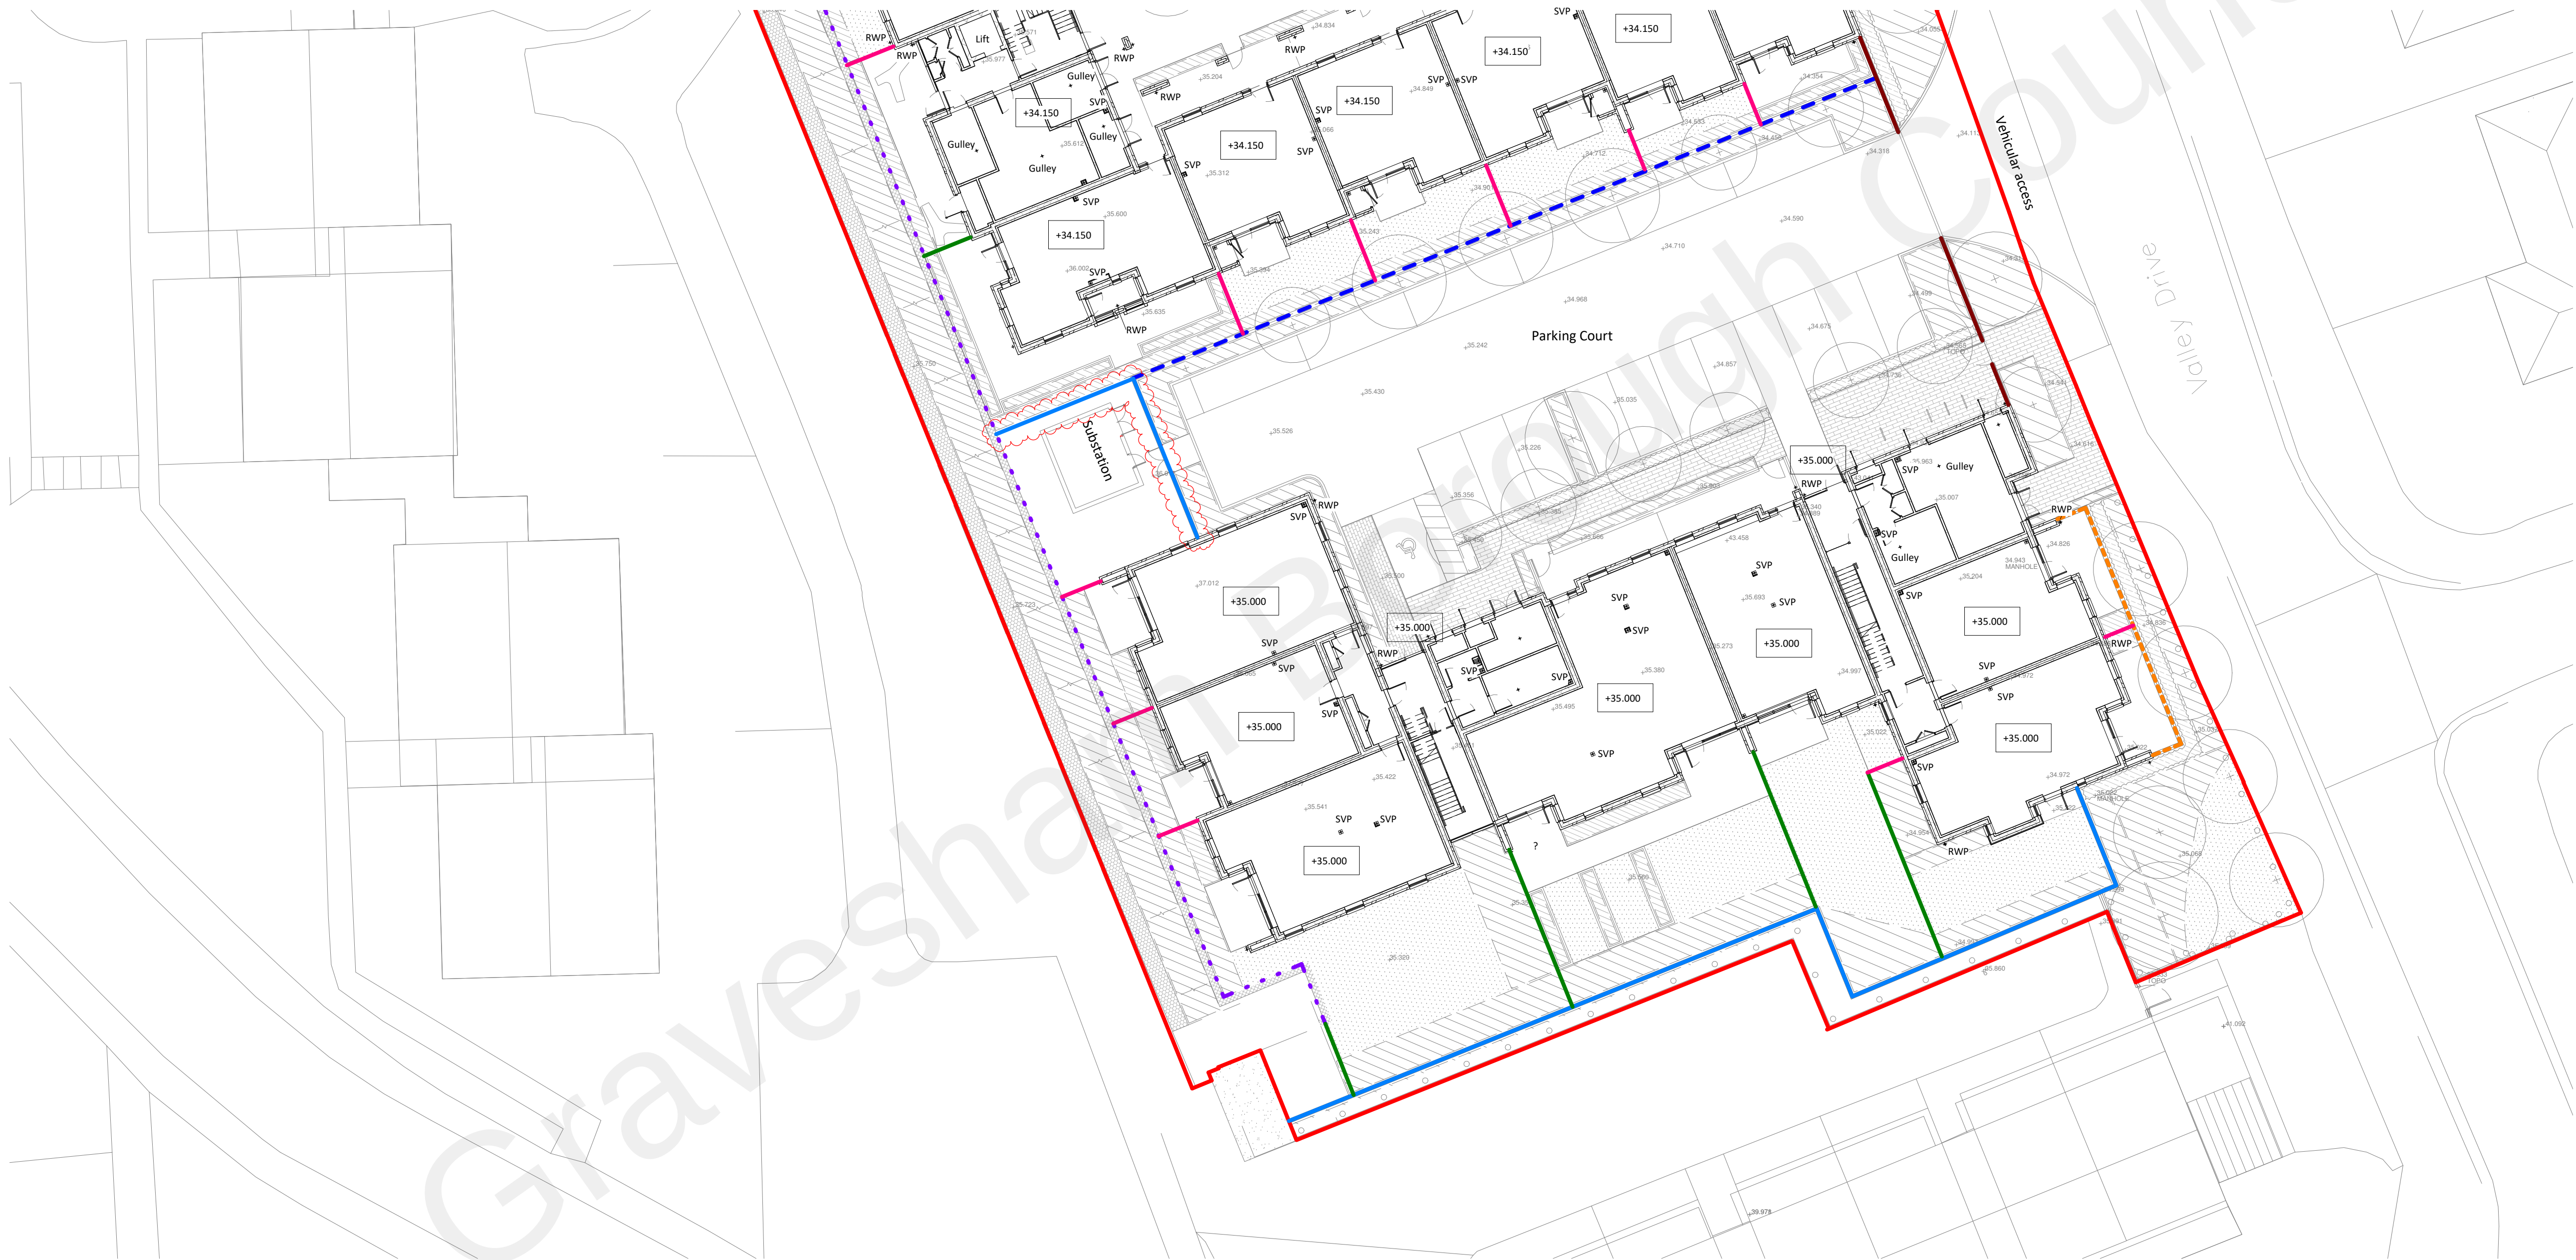


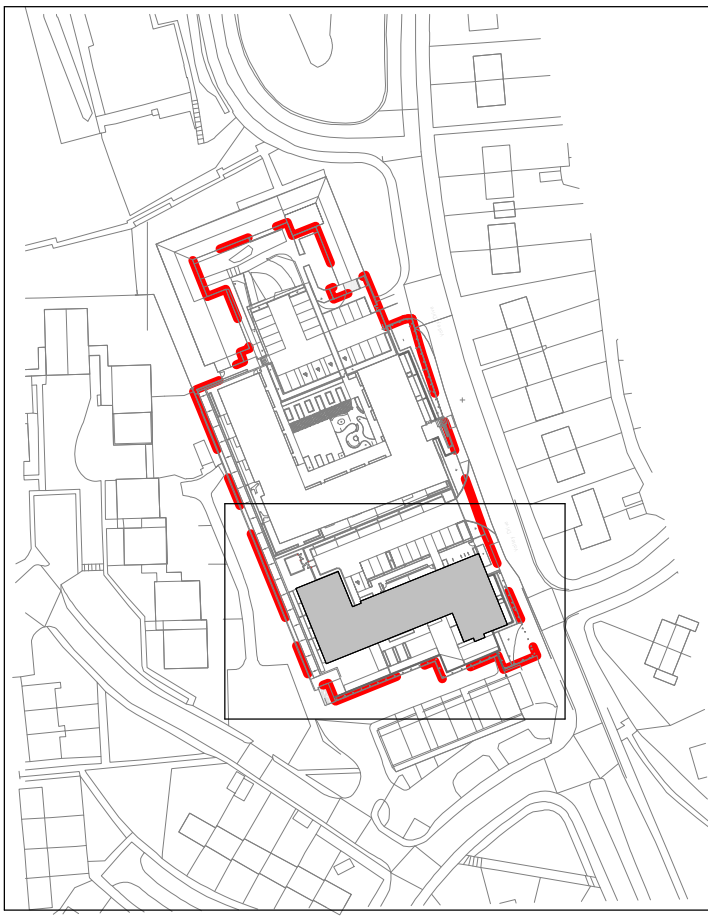

- KEY:**
- Planting / Hedges
 - Private outdoor spaces
 - Paving
 - Proposed site levels
 - Site Boundary
 - 450mm high brick dwarf wall with 1050mm high close boarded feather edge board fencing - pressure treated
 - 450mm high brick dwarf wall (to S.E design) with 1050mm top fixed metal railing - rectangular flat bar - PPC RAL 7016
 - 500mm Gabion retaining wall to S.E design
 - 1800mm high close boarded timber fence - pressure treated with concrete posts and concrete gravel boards.
 - 1800 high brick wall
 - 1800mm high treated timber privacy panel
 - 1800mm high close boarded feather edge board fencing - pressure treated, with concrete gravel boards
 - RC retaining wall to S.E design
 - 1500mm high metal railing with flat top - PPC RAL 7016 fixed within gabion retaining wall to S.E design.

NOTES

For site setting out and building coordinates refer to drawings 0100 Series.

For GA Setting out refer to drawings 1200 Series.

Below ground drainage, car park drainage and zones of permeable paving refer to Wallergray drawings.

To be read in conjunction with Wallergray, M&E Consultant and Landscape architect drawings.

Notes:

Do not scale. All dimensions are in millimetres unless otherwise stated. This drawing should be read in conjunction with all relevant project information and contract documentation. All dimensions to be checked prior to fabrication and or commencement of works. All works to comply with all relevant legal standards, building regulations and warranty provider requirements. Report any discrepancies, if in doubt ask.

Revisions:	Rev	Status	Date	Description	Drn	Chkd
PO1	S3		23.06.20	Preliminary Issue	CO	
PO2	S3		28.08.20	Drainage updated following updates to WCH unit. Lift shaft updated as per Kone information.	CO	
CO1	A5		19.03.21	Construction Issue	VM	
CO3	CR		14.03.22	Wall revised around car park entrance	TL	
CO3	CR		14.04.22	Railing & fencing key revised following Westridge comments	TL	
CO4	CR		09.05.22	Fencing specification revised following Westridge comments	TL	

Client Name:	Westridge
Project Name:	Valley Drive
Drawing Name:	Site Plan - Block B
Drawing Number:	VDR-BPTW-03-ZZ-DR-A-0102
Rev:	C04
Status:	CR
Project No:	19-251
RIBA Stage:	5
Drawn By:	VM
Scale:	1:200 @ A1

AS BUILT

40 Norman Road,
Greenwich, London
SE10 9GX
t 020 8293 5175
bptw.co.uk



1:200m