


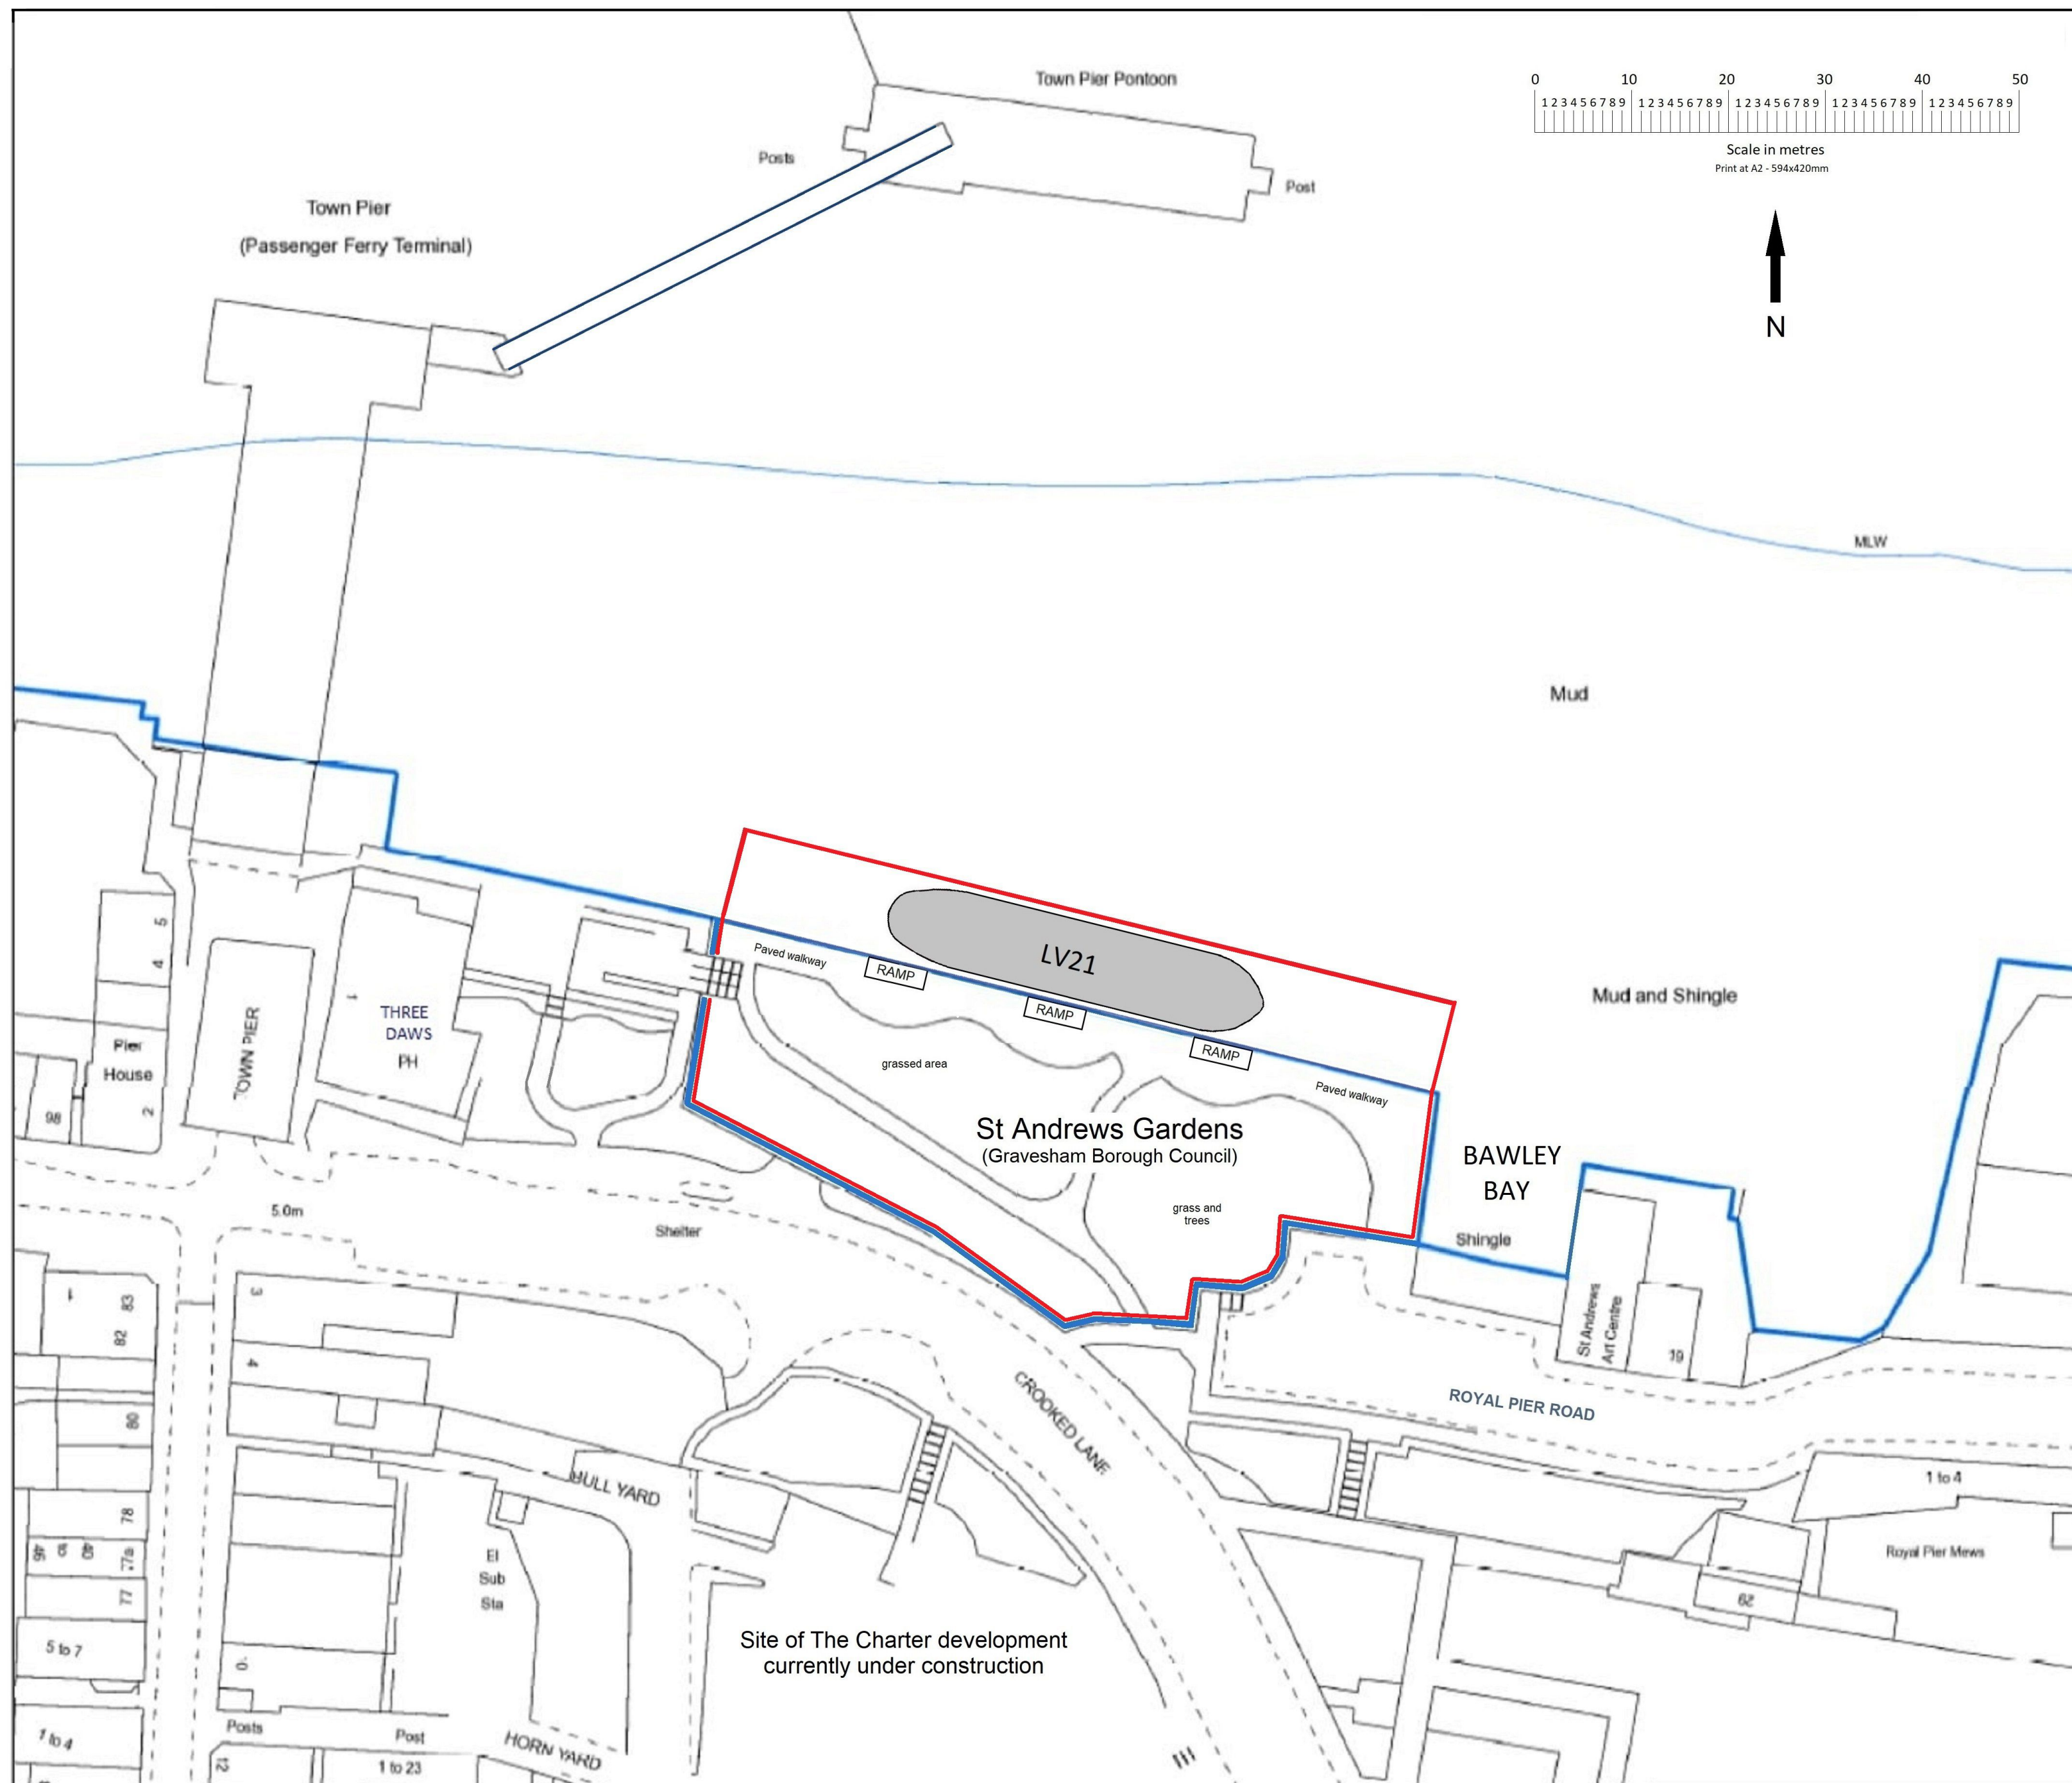

ST ANDREWS QUAY LOCATION PLAN AS EXISTING

SCALE: 1:500
PRINT AT A2
594mm x 420mm

DWG No: 001 Rev 3
(redline boundary enlarged as requested
by Gravesham Borough Council)

04/07/2023