


NOTE:

1 - Existing cellar stair relocated

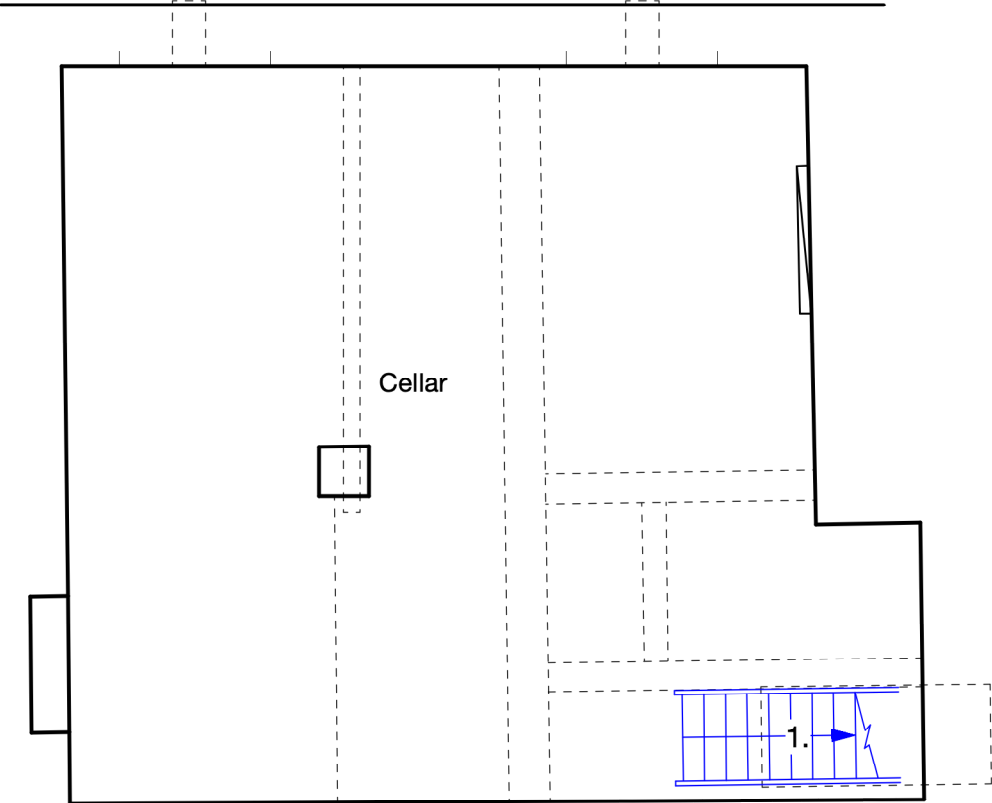

KEY:

Relocated element ———

GENERAL NOTES

- 1. This drawing is the copyright of Haines Phillips Architects.
- 2. Do not scale from this drawing. Use figured dimensions only.
- 3. This drawing must not be used for land transfer purposes, or for construction purposes unless accompanied by an Architect's Instruction.

DRAWING ISSUE STATUS

ISSUE STATUS		COMMENT
P	PRELIMINARY	For comment and review Planning/Listed Building Application
PL	PLANNING	
BR	BUILDING REGS	Building Regs Application For pricing purposes only
T	TENDER	
C	CONSTRUCTION	For procurement & construction
FC	FINAL	Record drawings on completion
L	CONSTRUCTION	
	LEGAL	Conveyancing or other legal purposes

REVISIONS

REV	DATE	NOTES
1	20/10/25	Planning Issue.

HAINES
PHILLIPS
ARCHITECTS

Tankerton Works
12 Argyle Walk
London WC1H 8HA
t 020 7833 9324
f 020 7837 2864
e office@hainesphillips.co.uk

JOB TITLE
Elizabeth House,
The Street, Meopham,
DA13 0AJ

DRAWING TITLE
Basement Plan As
Proposed

DRAWN	DATE
AZ	May 2025
JOB NR	SCALE
4412	1:50@A3
DRAWING NO.	ISSUE REVISION
GA320	PL 1

