



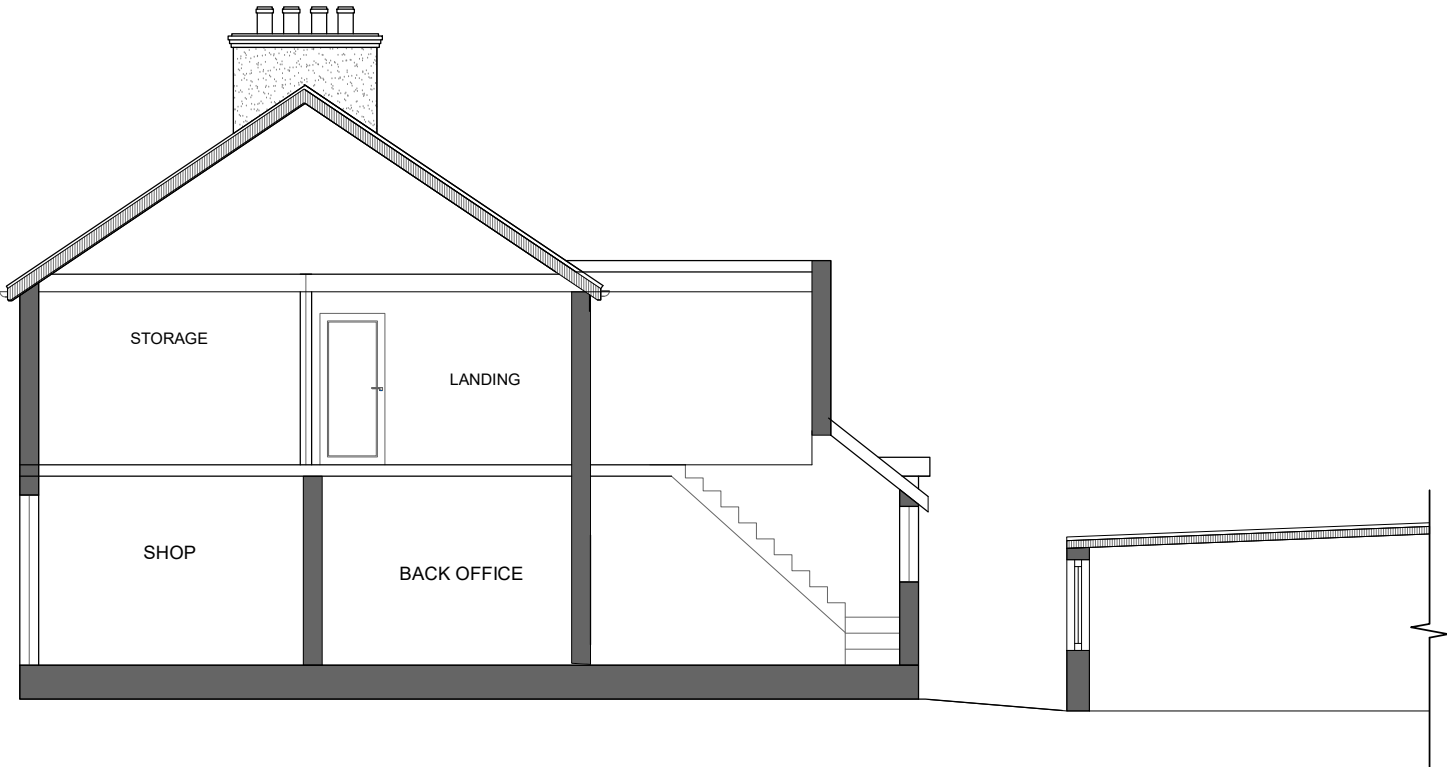

Existing Cross Section AA (As Built)

1 : 100

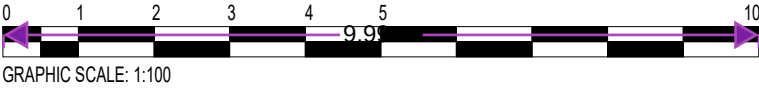

No .	Description	Date	6 Stonebridge Rd, Northfleet, Gravesend DA11 9DR	Client Mr R Mathusan		REF .	REV	
				Date Apr 2025	Sheet number R-PL/6SR/SD105	Scale (@ A3) 1 : 100		
			Existing Cross Section (As Built)	Sanaa Designs				
				Email - sanaadesigns@outlook.com				
				Mobile - 07583 437570				
			Drawn MMK					
			Checked by TK					