

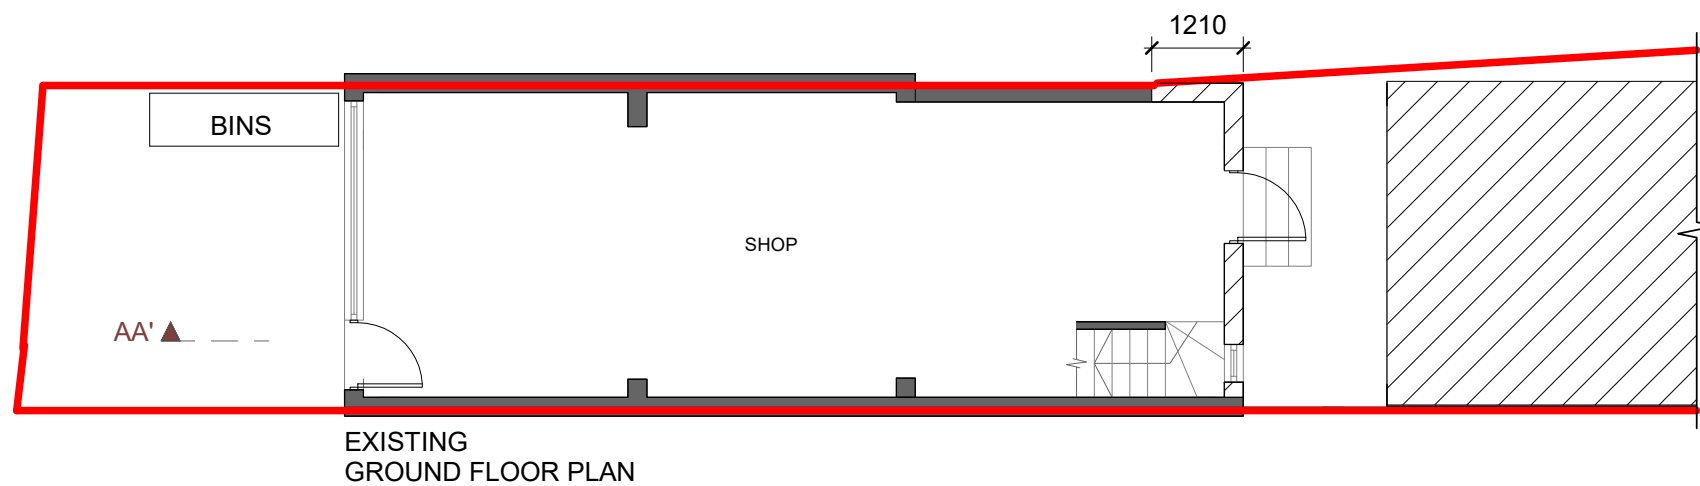
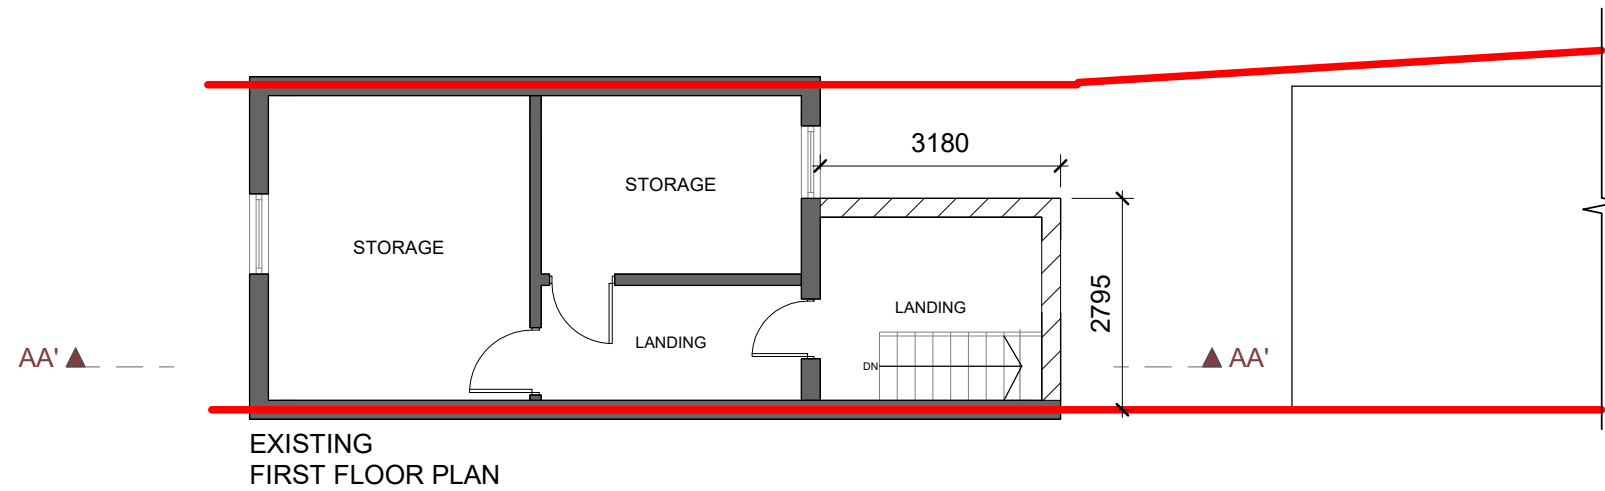


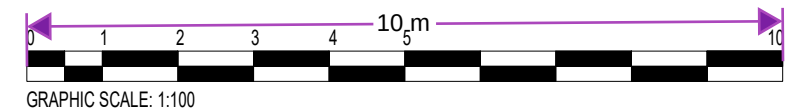

Existing Plans (As Built)

1 : 100

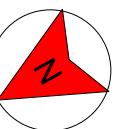

No .	Description	Date	6 Stonebridge Rd, Northfleet, Gravesend DA11 9DR	Client Mr R Mathusan		REF .	REV
				Date Apr 2025	Sheet number R-PL/6SR/SD103	Scale (@ A3) 1 : 100	
			Drawn MMK		Sanaa Designs Email - sanaadesigns@outlook.com Mobile - 07583 437570		
			Checked by TK				
Existing Plans (As Built)							