



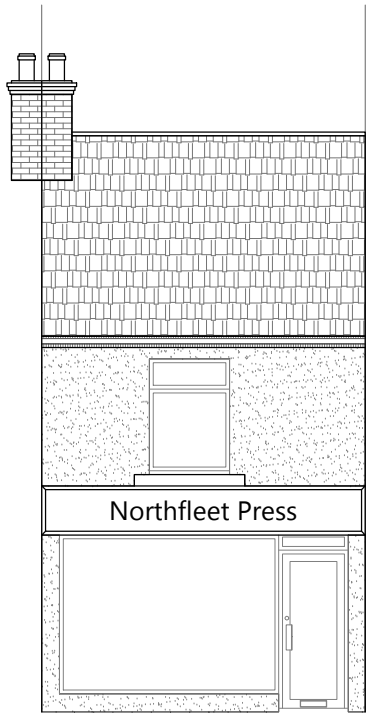


AS BUILT
FRONT ELEVATION

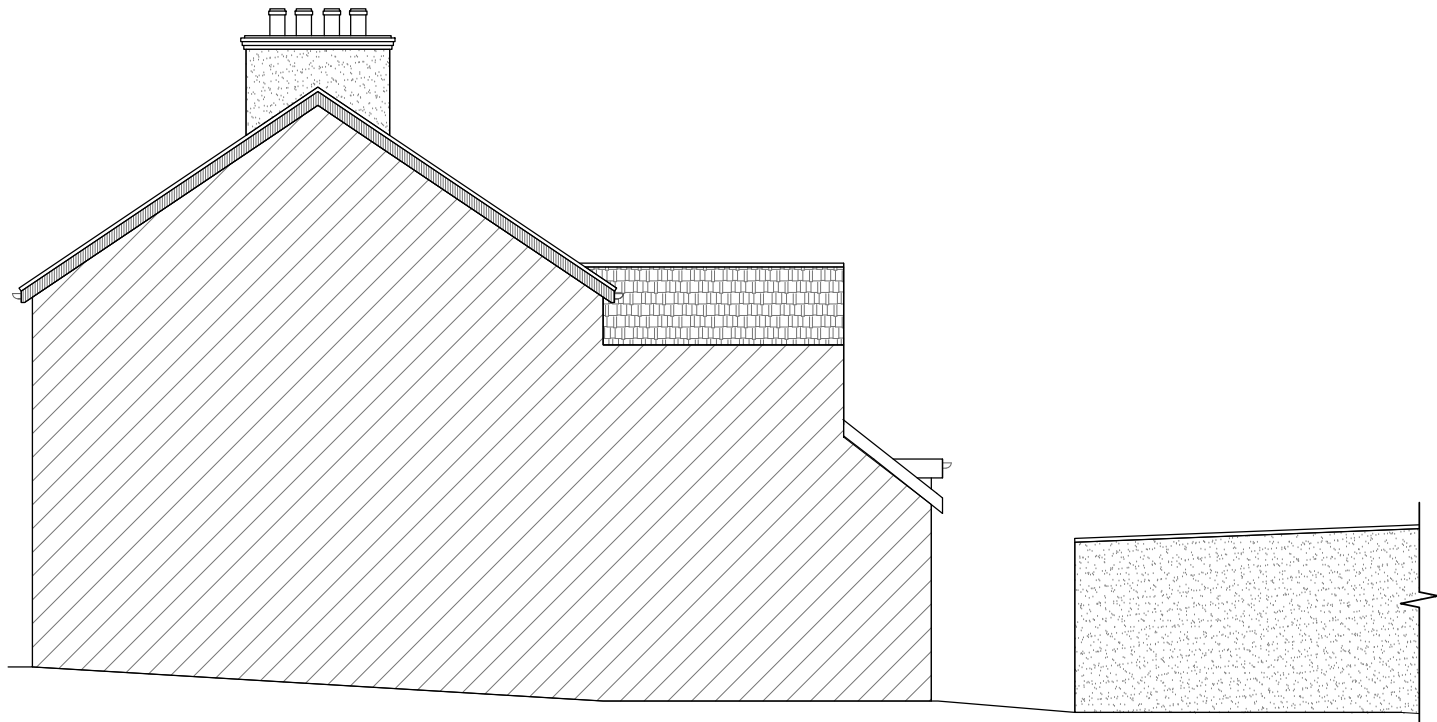

AS BUILT
RH ELEVATION




AS BUILT
REAR ELEVATION

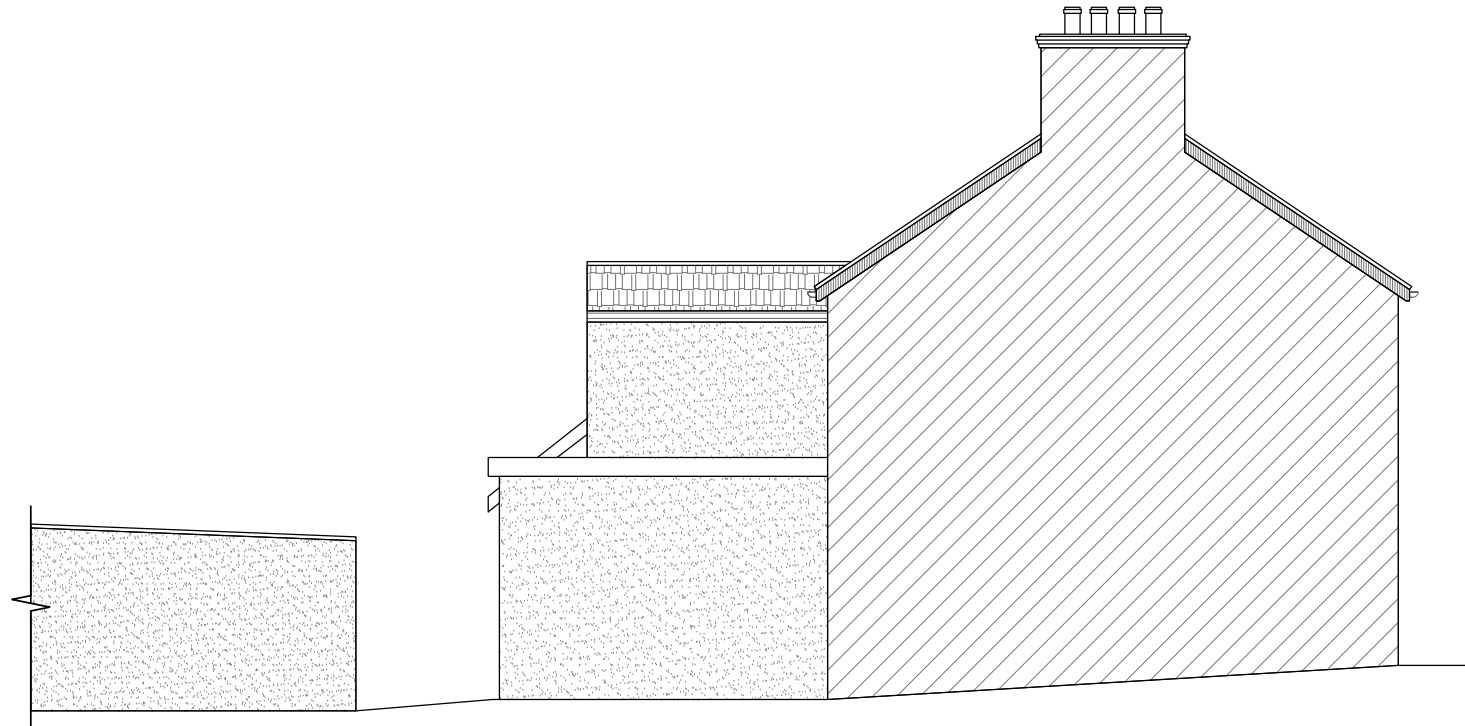

AS BUILT
LH ELEVATION

Existing Elevations (As Built)

1 : 100

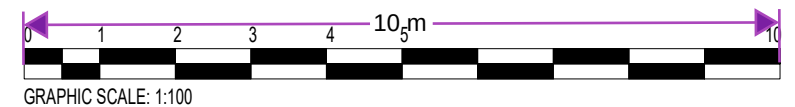

No .	Description	Date	6 Stonebridge Rd, Northfleet, Gravesend DA11 9DR	Client		REF	REV
				Mr R Mathusan		.	
			Existing Elevations(As Built)	Date Apr 2025	Sheet number R-PL/6SR/SD104	Scale (@ A3) 1 : 100	
				Drawn MMK	Sanaa Designs Email - sanaadesigns@outlook.com Mobile - 07583 437570		
				Checked by TK			