




- Do not scale from this drawing.
- All dimensions to be verified on site and is in mm.
- Builder to verify all dimensions, heights and levels prior to commencement of work.
- All documents shall be checked to ensure that they are compatible by the contractor before construction commences. In the event of apparent ambiguity or contradiction the engineer and/ or architect shall be notified immediately.
- The contractor in preparing his estimate shall visit the site and acquaint himself with the problems involved.
- The contractor shall issue all statutory notices to the local Authority during progress and completion of works.

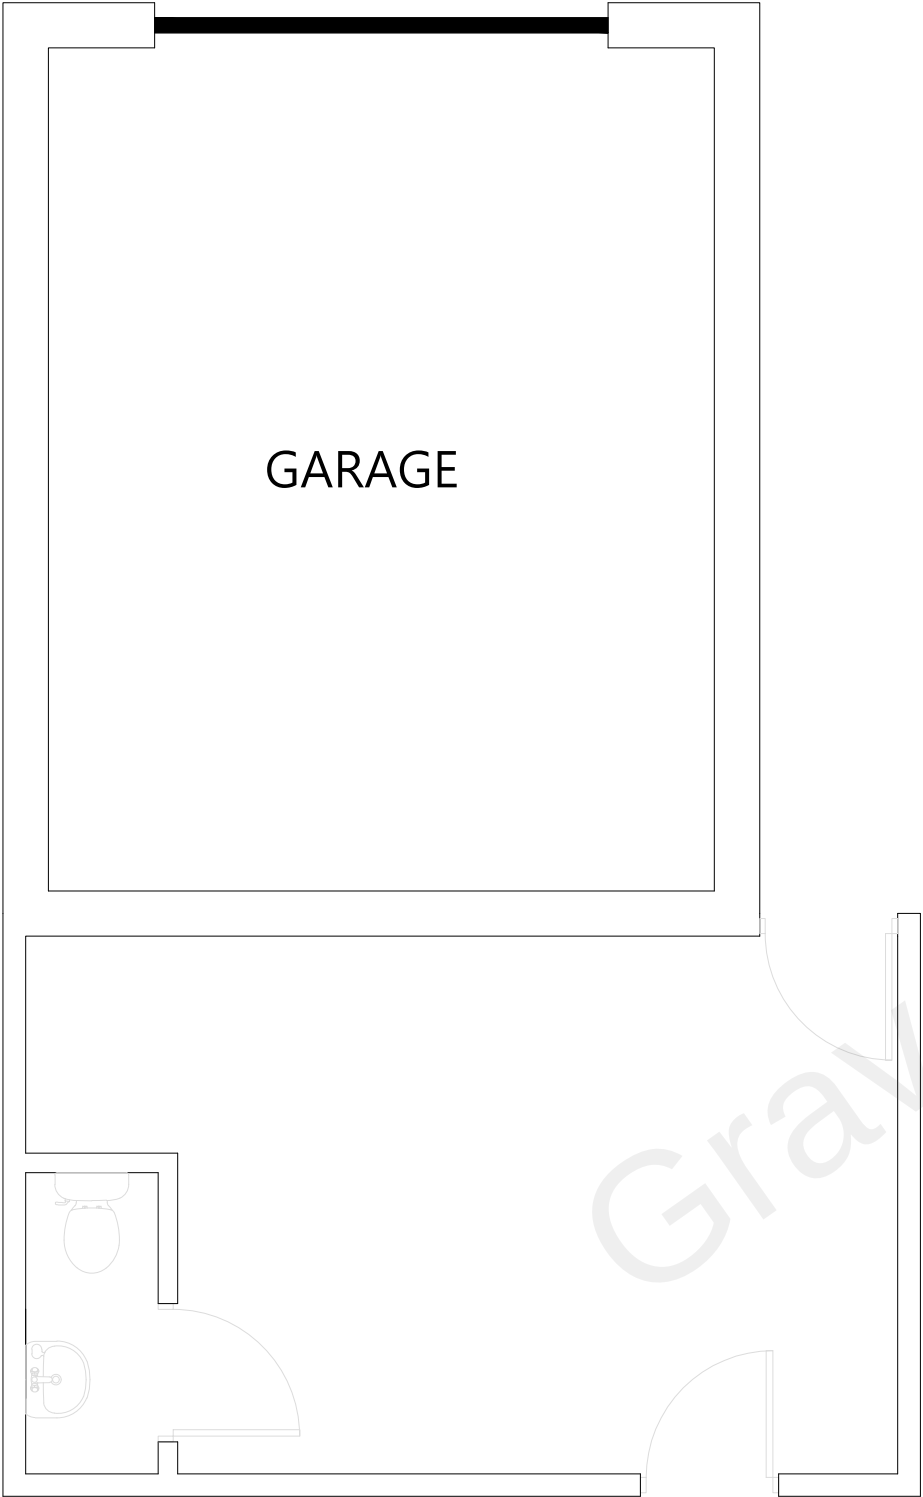


Floor Plan (as built on site)

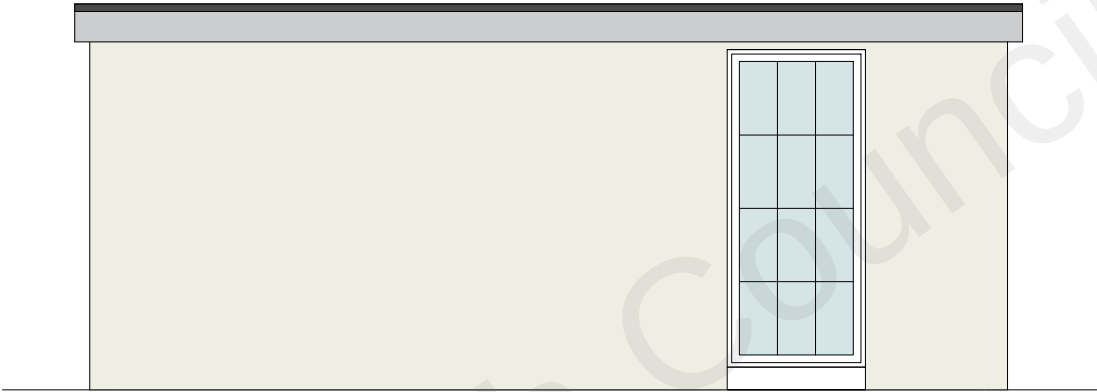

Front Elevation (as built on site)

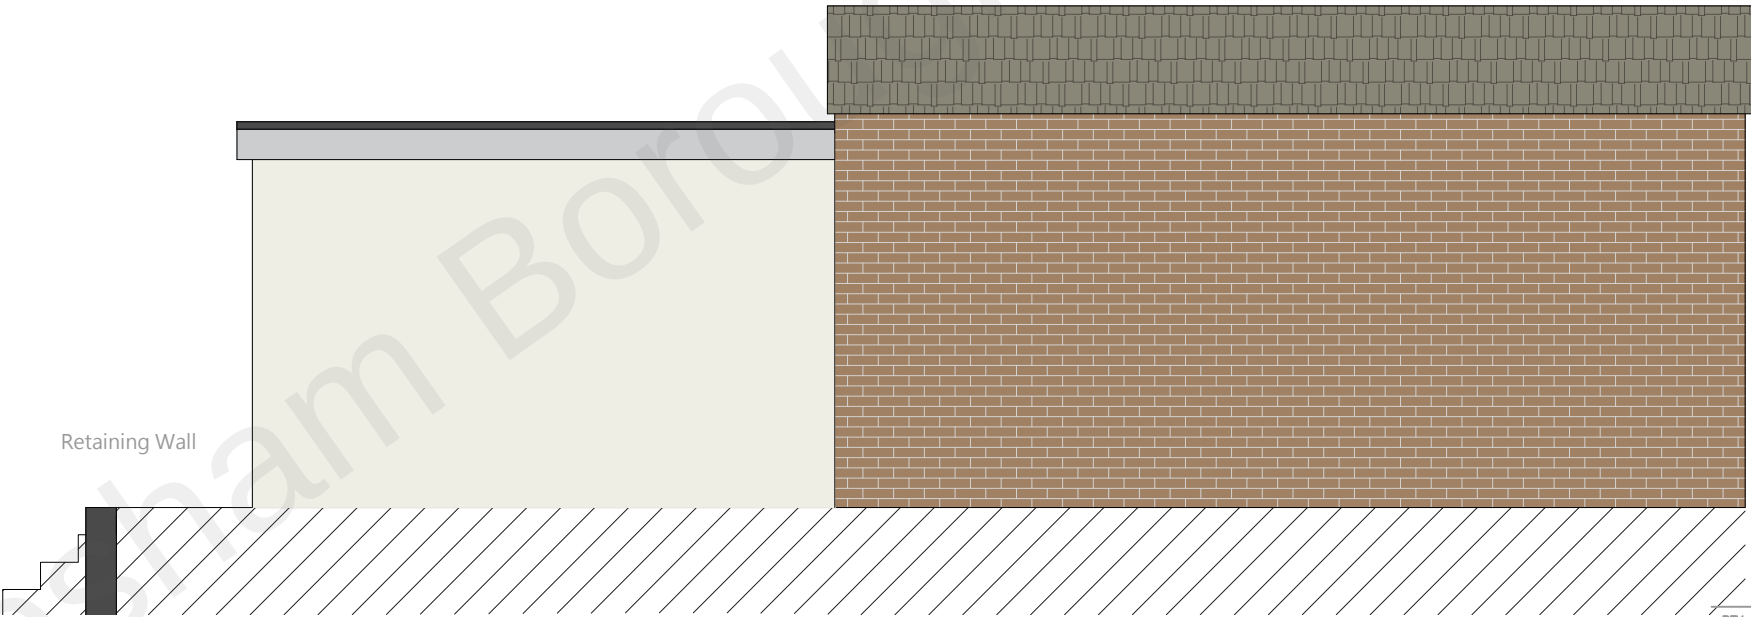

Side Elevation (as built on site)

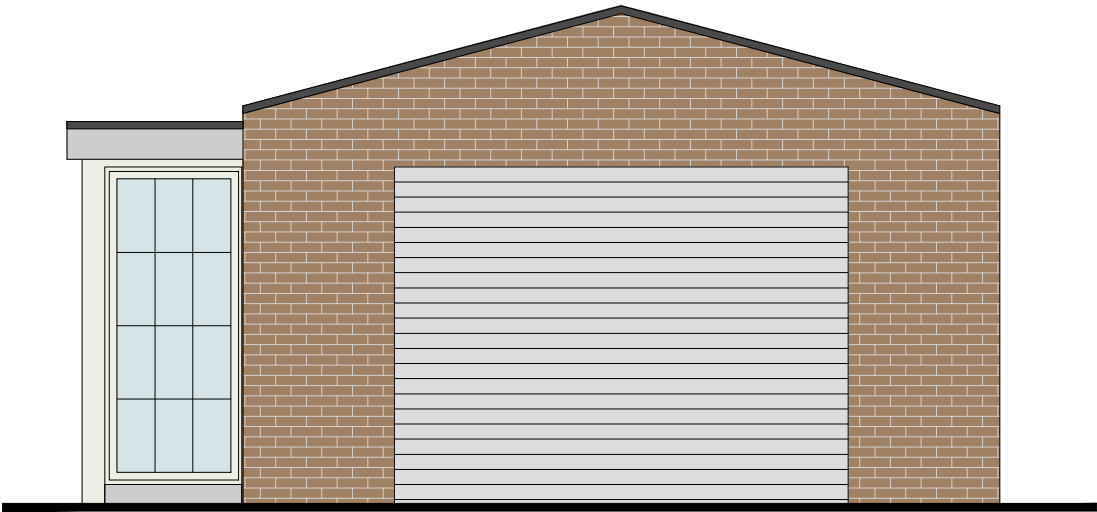

Rear Elevation (as built on site)

REV:	DESCRIPTION:	BY:	DATE:
STATUS:	PLANNING		



Whitehall Place
47 The Terrace,
Gravesend, Kent
DA12 2DL
01474 247 787
info@barronedwards.co.uk
www.barronedwards.co.uk

SITE:	130 Old Road East Gravesend DA12 1PF
-------	--

TITLE:	Plans and Elevations As Built on Site
--------	--

SCALE AT A3: 1:50	DATE: 30.06.2022	DRAWN: HE
PROJECT NO: 210711	DRAWING NO: 004	REVISION: A

