



DISH DETAILS TO BE REMOVED							
I.D. No.	ITEM	TYPE / SIZE	BEARING	MEAN HEIGHT	FEEDER LENGTH	FEEDER TYPE	No. OF FEEDERS
EQU900268332	D1	1.2m DISH	98°E.T.N.	31.5m	40.0m	LDF4-50	3
PROPOSED DISH DETAILS							
I.D. No.	ITEM	TYPE / SIZE	BEARING	MEAN HEIGHT	FEEDER LENGTH	FEEDER TYPE	No. OF FEEDERS
EQU200000000291274	D2	1.2m DISH	98°E.T.N.	33.5m	40.0m	LDF4-50	3

©2020 Cellnex
All rights reserved. No part of this publication may be reproduced, stored in a retrieval system or transmitted in any form or by any means (Electronic, Mechanical, Photocopying, Recording or otherwise), without the prior written consent of the Company.

NOTES

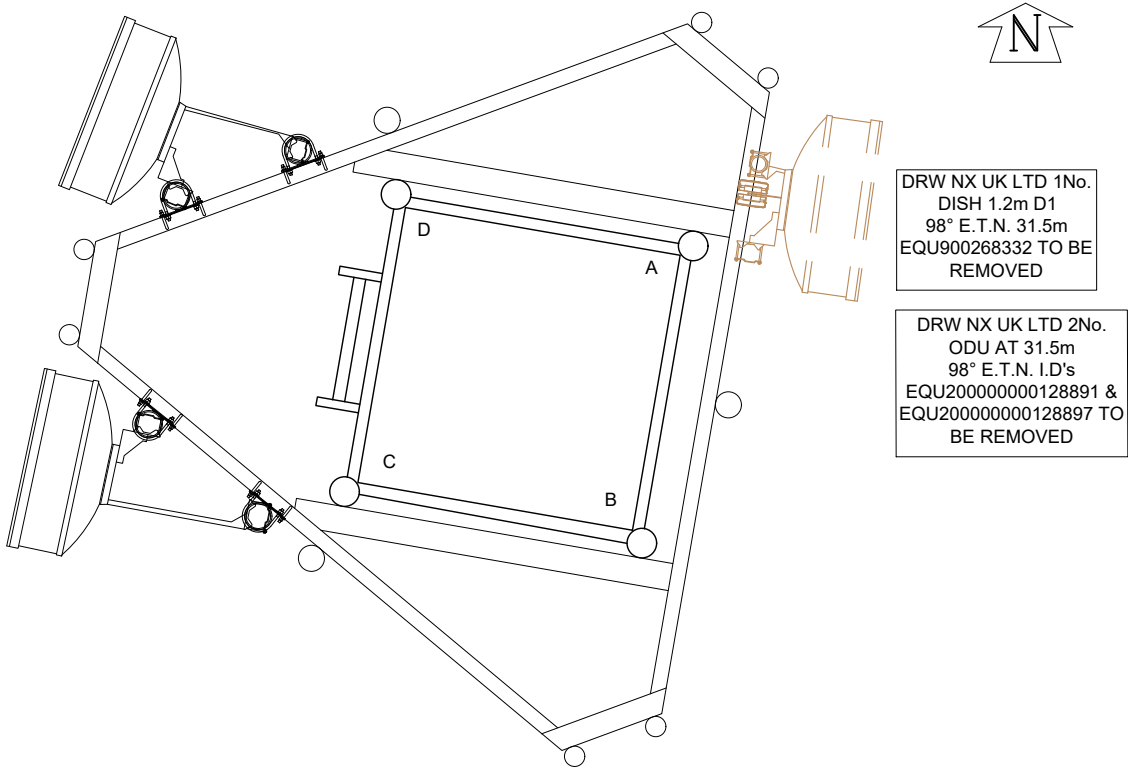

TOWER PLAN AT 31.5m
SCALE 1:50

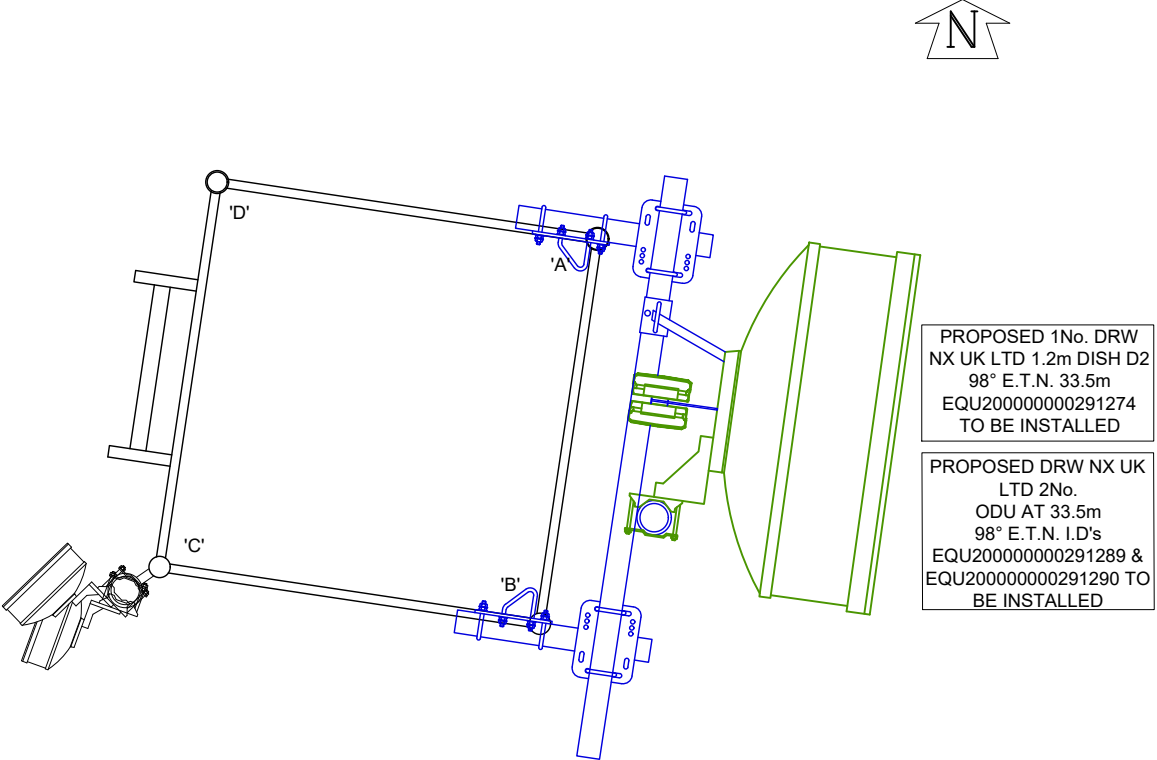

TOWER PLAN AT 33.5m
SCALE 1:25



FEINT DETAILS INDICATE LOCATIONS
RESERVED FOR OTHER PROPOSALS
WHICH MAY BE THE SUBJECT OF
SEPARATE APPLICATIONS

PROJ No.	COL.MOD.UK.0002194			
18.A	COL.MOD.UK.0002194 PLANNING ISSUE		HFC	
18	COM-0026193 AS BUILT	23/06/23	HFC	MIT
17	202881 PLANNING ISSUE	25/01/19	HFC	LBG
16	200969 DECOM	02/05/18	BB	MF
15	193734 AS BUILT	18/07/17	HFC	MF
ISS	REVISION	DATE	DRN	APP

CELLNEX UK
R+, 4TH FLOOR, 2 BLA GRAVE STREET, READING, RG1 1AZ
Tel. 020 4526 8553

SITE No 1490517
INN ON THE LAKE
INN ON THE LAKE HOTEL
OFF WATLING STREET (A2)
GRAVESEND
KENT
DA12 3HB

NGR TQ 67660 69840

OS GRID 567660 169840

TITLE
ANTENNA PLAN
PROPOSED
DRW NX UK LTD


SCALE 1:50 & 1:25

DRAWN	IM	28/05/11
APPROVED		


DRG No.	Sheet 1 of 1	Rev
1490517-32-151-MD018	18.A	

PROPOSED DRW NX UK LTD 1No. 1.2m DISH I.D. No. EQU200000000291274
98° E.T.N. AT 33.5m TO BE INSTALLED ON TOWER LEG

PROPOSED DRW NX UK LTD 2No. SHF ODU I.D. No. EQU200000000291289 &
EQU200000000291290 E.T.N. AT 33.5m TO BE INSTALLED ON TOWER LEG

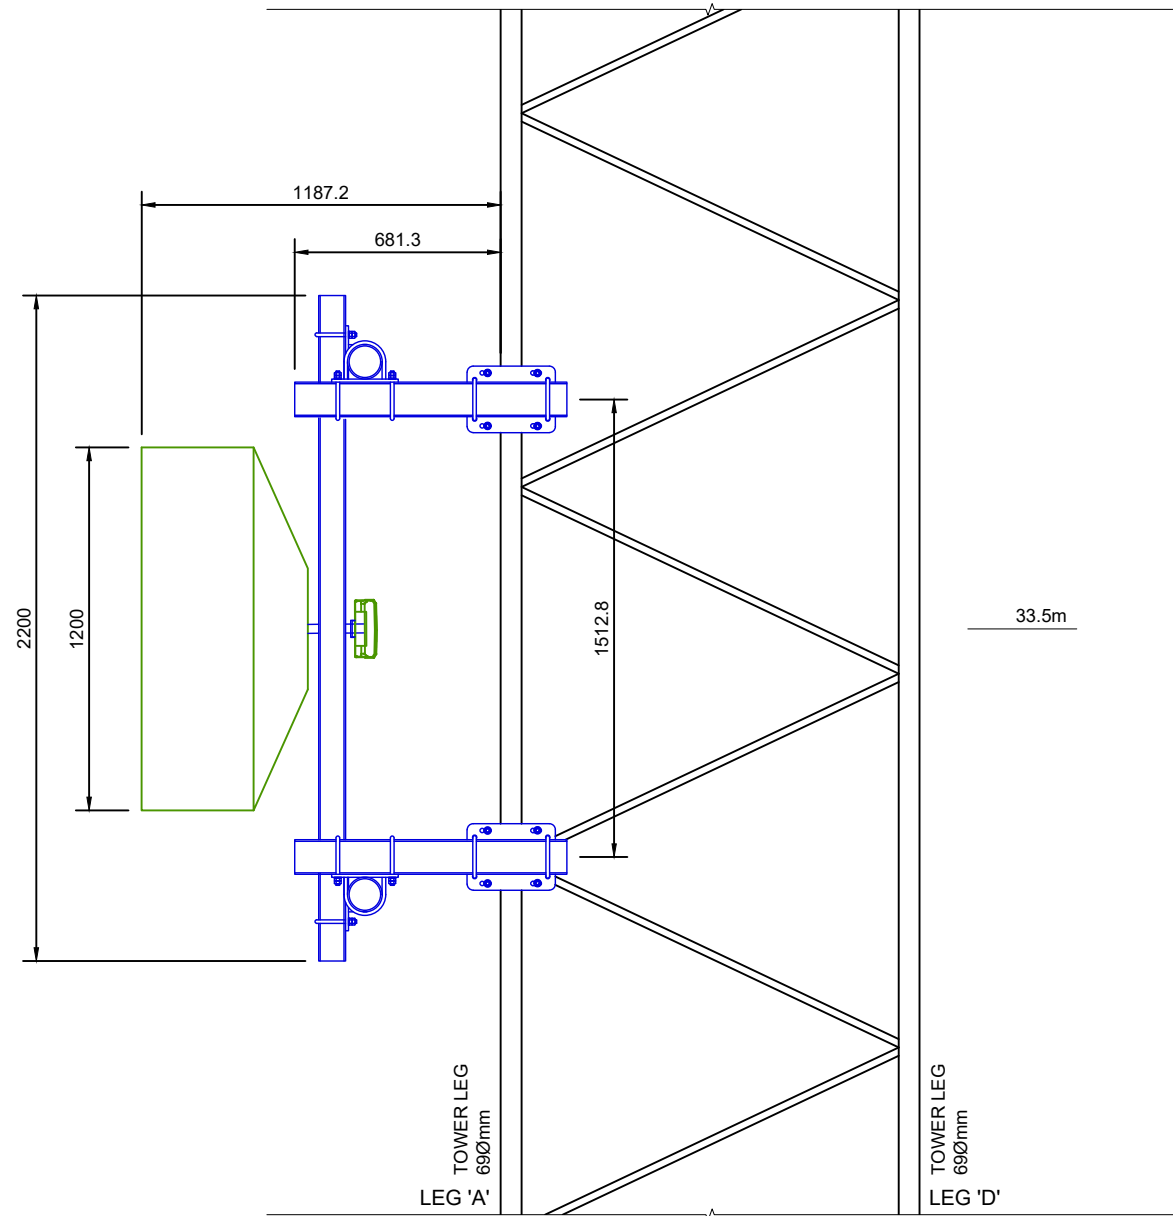

TOWER ELEVATION AT 33.5m
SCALE 1:25

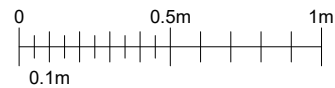

PROPOSED DISH DETAILS

I.D. No.	ITEM	TYPE / SIZE	BEARING	MEAN HEIGHT	FEEDER LENGTH	FEEDER TYPE	No. OF FEEDERS
EQU200000000291274	D2	1.2m DISH	98°E.T.N.	33.5m	40.0m	LDF4-50	3

©2020 Cellnex
All rights reserved. No part of this publication may be reproduced, stored in a retrieval system or transmitted in any form or by any means (Electronic, Mechanical, Photocopying, Recording or otherwise), without the prior written consent of the Company.

NOTES

PROJ No.	COL.MOD.UK.0002194
18.A	COL.MOD.UK.0002194 PLANNING ISSUE
18	COM-0026193 AS BUILT
17	202881 PLANNING ISSUE
16	200969 DECOM
15	193734 AS BUILT
ISS	REVISION
	DATE
	DRN
	APP

 CELLNEX UK R+, 4TH FLOOR, 2 BLA GRAVE STREET, READING, RG1 1AZ Tel. 020 4526 8553		
SITE No 1490517 INN ON THE LAKE INN ON THE LAKE HOTEL OFF WATLING STREET (A2) GRAVESEND KENT DA12 3HB		
NGR	TQ 67660 69840	
OS GRID	567660 169840	
TITLE ANTENNA ELEVATION DETAIL PROPOSED DRW NX UK LTD		
SCALE	1:25	
DRAWN	IM	28/05/11
APPROVED		
DRG No.	Sheet 1 of 1	Rev
1490517-32-152-MD018	18.A	

FEINT DETAILS INDICATE LOCATIONS
RESERVED FOR OTHER PROPOSALS
WHICH MAY BE THE SUBJECT OF
SEPARATE APPLICATIONS