




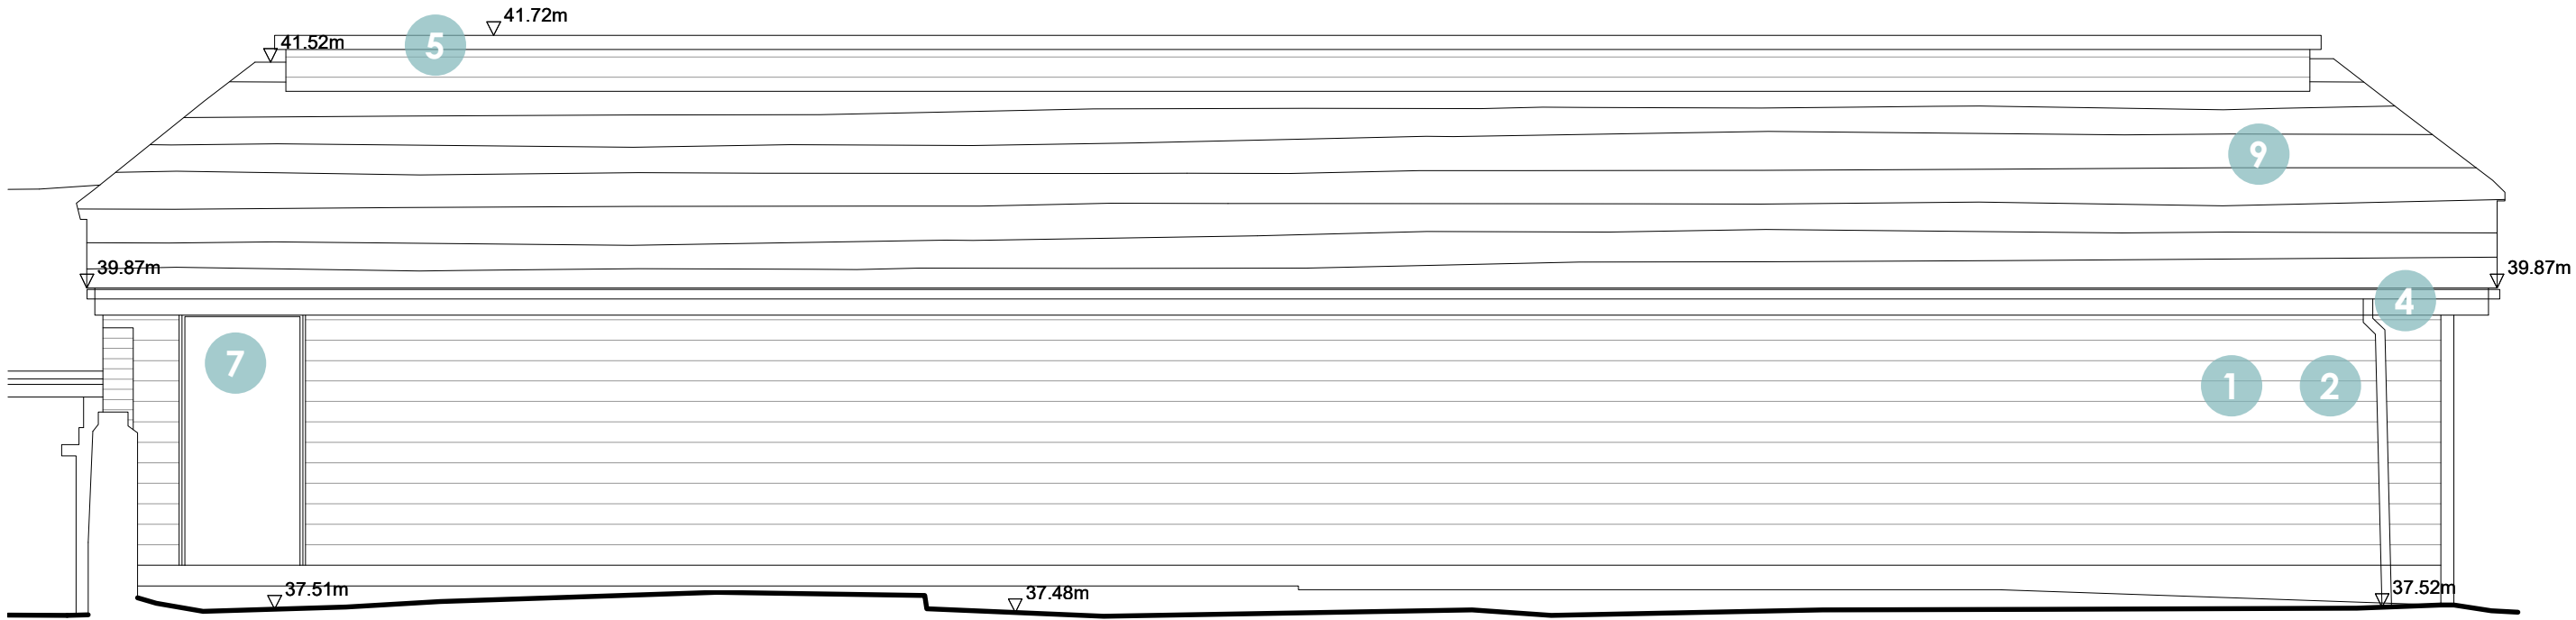



Proposed Elevation 23 as constructed

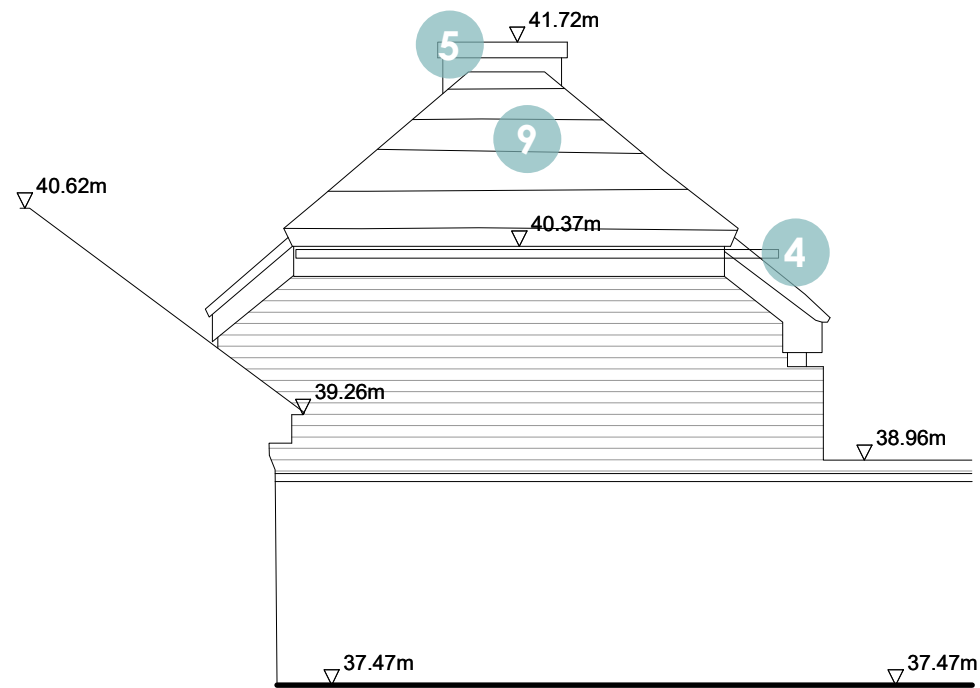

Proposed Elevation 24 as constructed

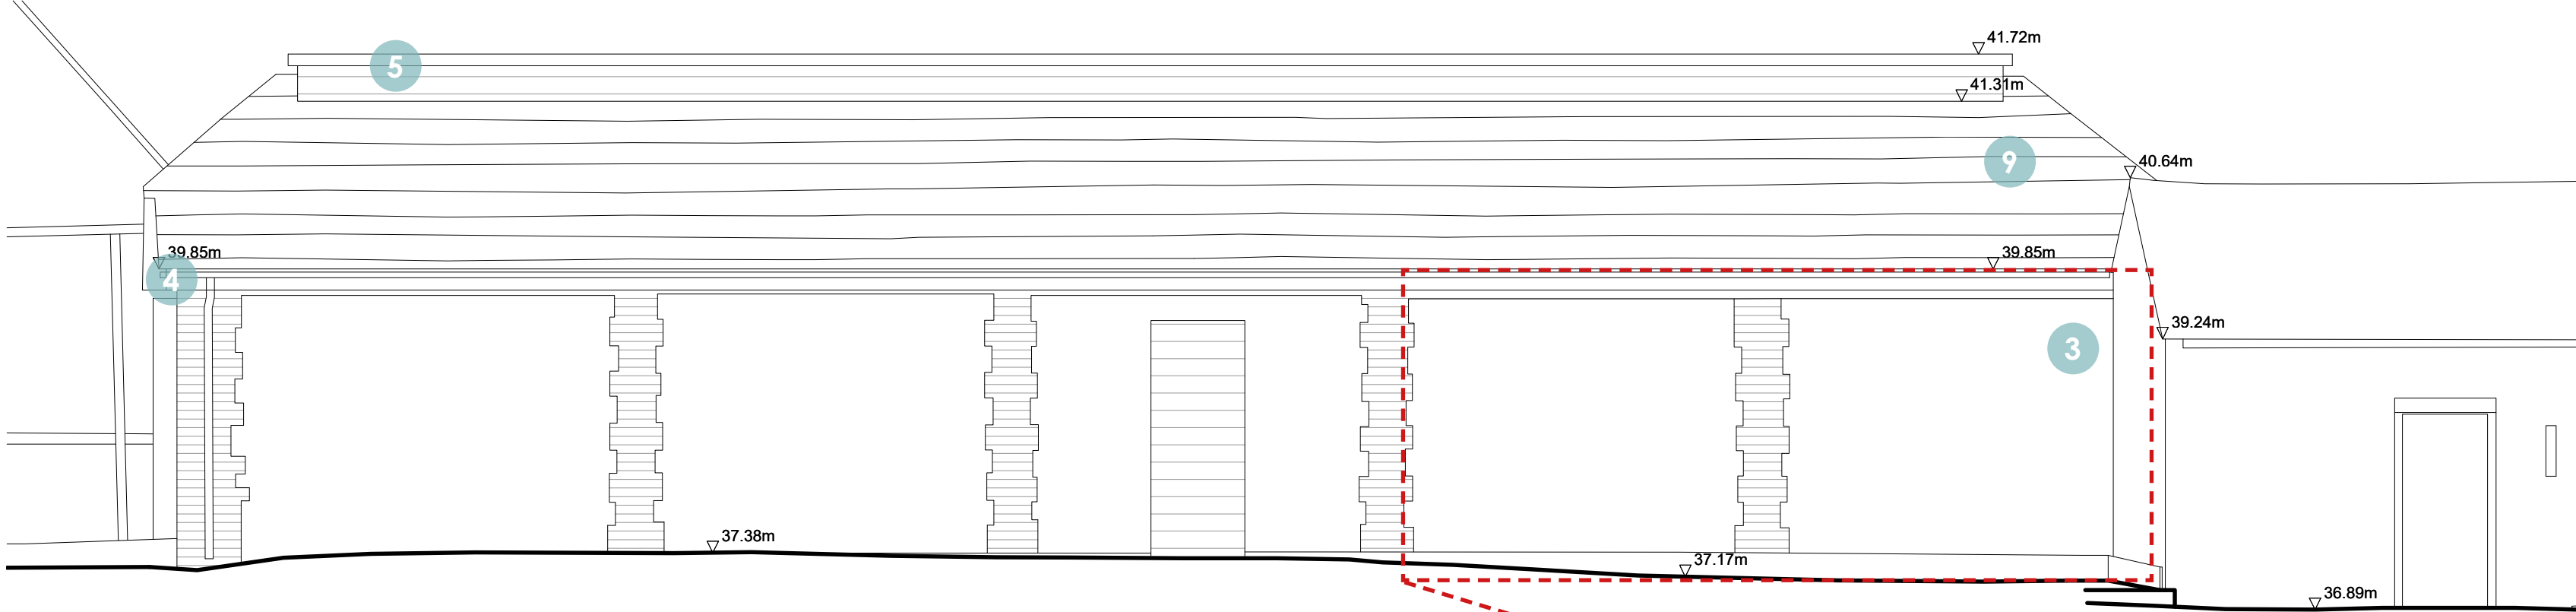

Proposed Elevation 28 as constructed

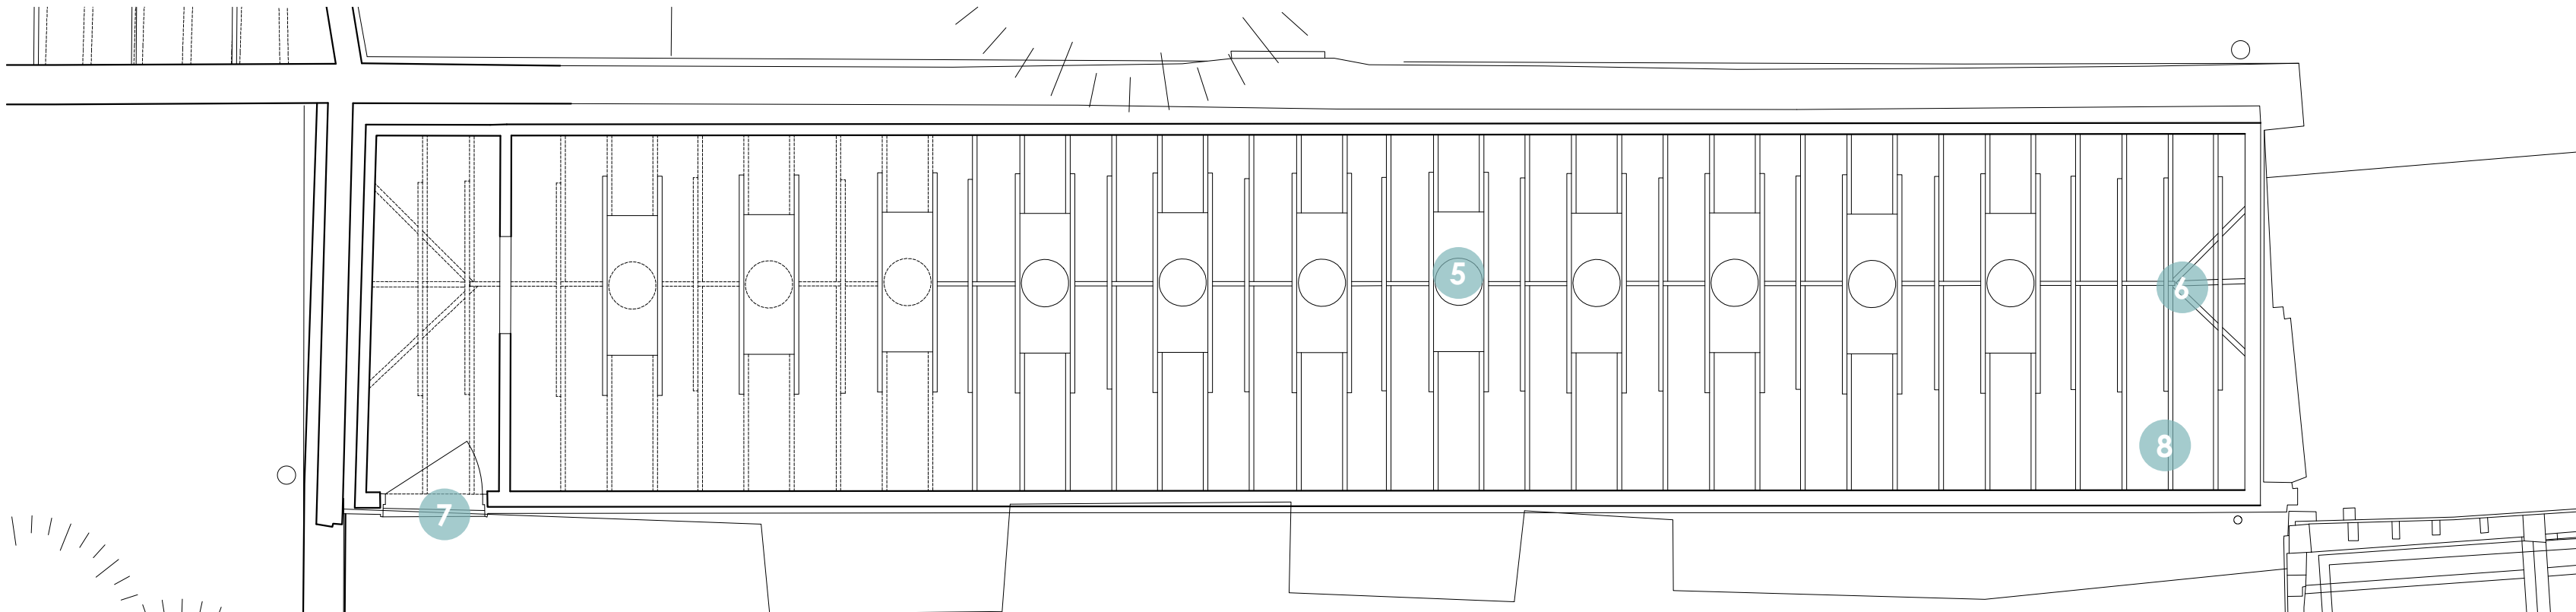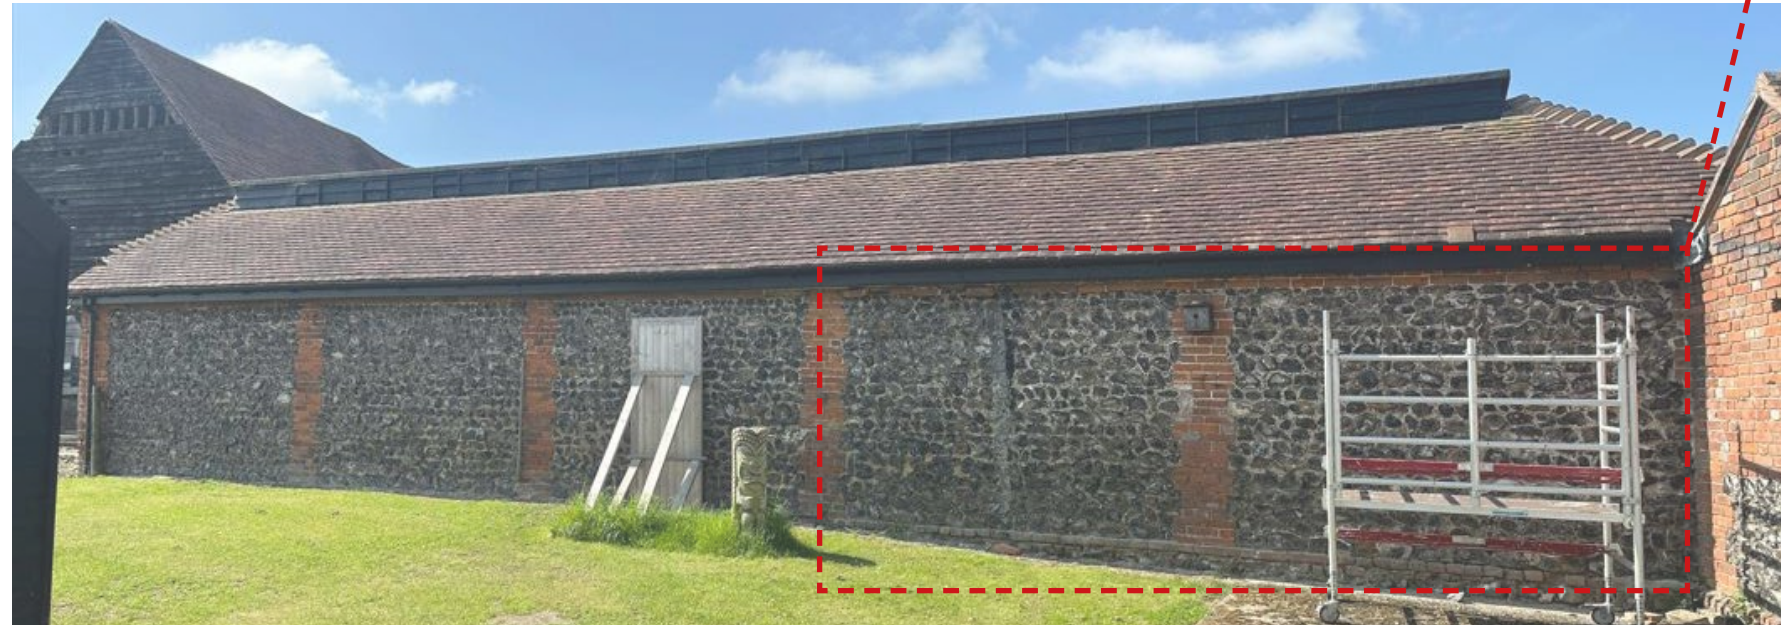

Proposed Floor Plan as constructed

This drawing and the design are the copyright of **ON Architecture Ltd only**.
This drawing should not be copied or reproduced without written consent.

All dimensions are to be checked on site prior to setting out and fabrication and **ON Architecture Ltd** should be notified of any discrepancy prior to proceeding further.

For Construction & Fabrication Purposes - Do not scale from this drawing, use only the illustrated dimensions herein. Additional dimensions are to be requested and checked directly.


Illustrated information from 3rd party consultants/specialists is shown as indicatively only. See other consultant / specialist drawings for full information and detail.

All aspects of the architectural design concerning fire performance / fire safety (whether or not illustrated / annotated) are to be considered as 'For Approval' only, irrespective of the drawing status / suitability.

Scale: 1:50

0 1 3 5m

Key:

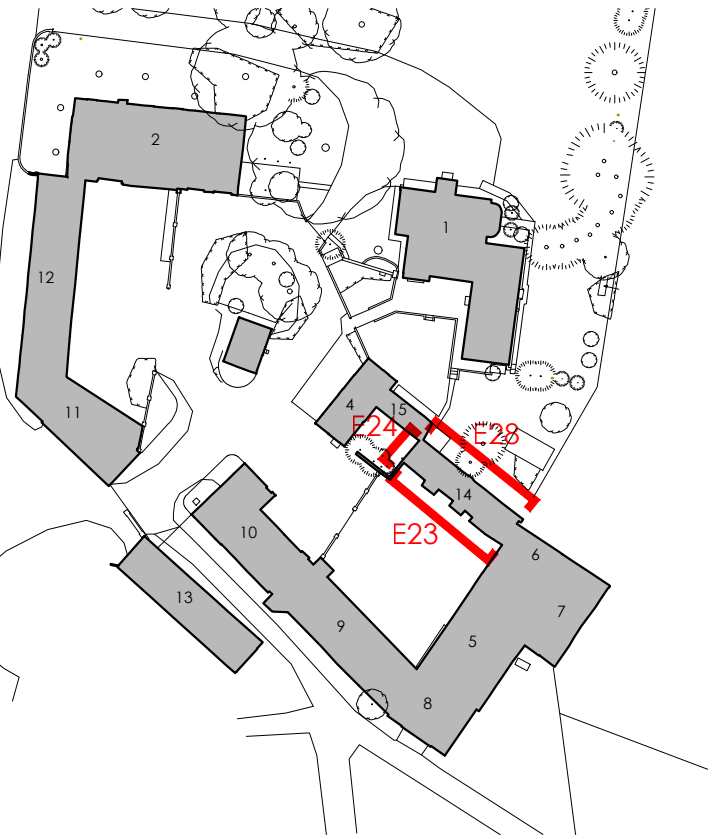

Materials:

- 1 Pre-treated black / feather-edge timber cladding
- 2 Blackbird paint
- 3 Flint wall repaired using lime mortar mix (area of repair highlighted)
- 4 FloPlast uPVC guttering
- 5 Roof cowls (ventilated roof ridge)
- 6 Timber roof structure
- 7 Black ledger & braced, ply face door
- 8 Concrete floor slab
- 9 Tudor Plan Pegs roof tiles, 50% Medium Antique & 50% Red antique

All survey drawings produced by OmegaGeo
Please refer to Job Ref. 2414908, Drawing no. 2 of 3
for further details

Revision Note & Date		Note		Amended		Checked	
Rev	Date						

ON
ARCH
TECT
URE

Canterbury Studio
Logan House, St Andrews Close
Canterbury,
CT1 2RP

info@onarchitecture.co.uk
onarchitecture.co.uk
01227 634334

Project Title
WHITEHOUSE FARM, LAND WAY

Client Details
WINDMILL CONSTRUCTION

Drawing Title
**BUILDING 14 - PROPOSED FLOOR
PLAN AND ELEVATIONS AS
CONSTRUCTED**

8/11 Number
24.051-ONA-ZZ-XX-DR-A - 0305.000

Scale Date Drawn Checked
1:50 @ A1 MAY 2024 IH JR

Drawing Status
PLANNING

Project No.	Drawing No.	Status	Revision
24.051	0305.000	P	----