




Western Elevation

Scale 1:100  
0 0.5 1 2 3 4 5 6 7 8 9 10

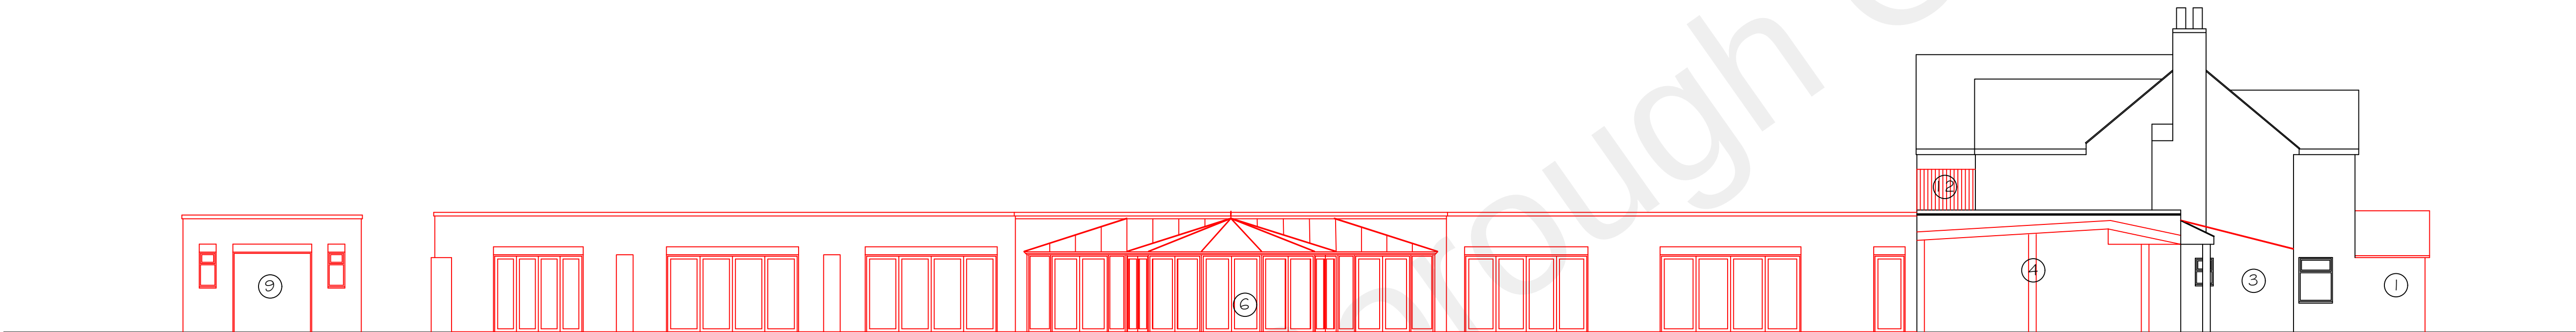

Northern Elevation

Scale 1:100  
0 0.5 1 2 3 4 5 6 7 8 9 10



Eastern Elevation

Scale 1:100  
0 0.5 1 2 3 4 5 6 7 8 9 10

Rev B- Additional information added.  
Rev A- Red line highlight added.

13 October 2022  
6 October 2022

|                                                                                                                                                                                                       |           |   |
|-------------------------------------------------------------------------------------------------------------------------------------------------------------------------------------------------------|-----------|---|
| <div><div>Copyright</div><div><div>Synergy</div><div>Planning &amp; Property Consultants Ltd</div><div>The Office</div><div>The Larches</div><div>Rochester</div><div>Kent ME3 7NQW</div></div></div> |           |   |
| Client                                                                                                                                                                                                |           |   |
| Mrs Mattu                                                                                                                                                                                             |           |   |
| Address                                                                                                                                                                                               |           |   |
| The Orchards Higham Kent                                                                                                                                                                              |           |   |
| Drawing title                                                                                                                                                                                         |           |   |
| Elevations post 2009                                                                                                                                                                                  |           |   |
| Scale                                                                                                                                                                                                 |           |   |
| 1:100                                                                                                                                                                                                 |           |   |
| Date                                                                                                                                                                                                  | Drawn by  |   |
| 30 July 2022                                                                                                                                                                                          |           |   |
| Drawing No                                                                                                                                                                                            | 22/380/05 | B |