

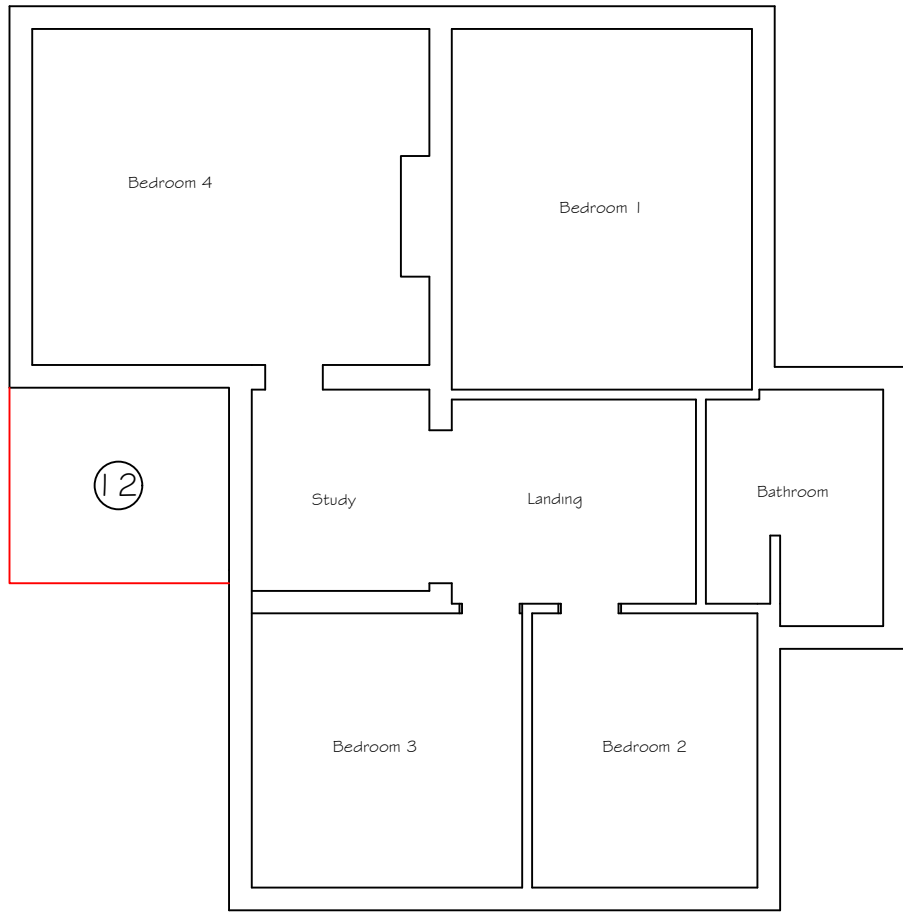


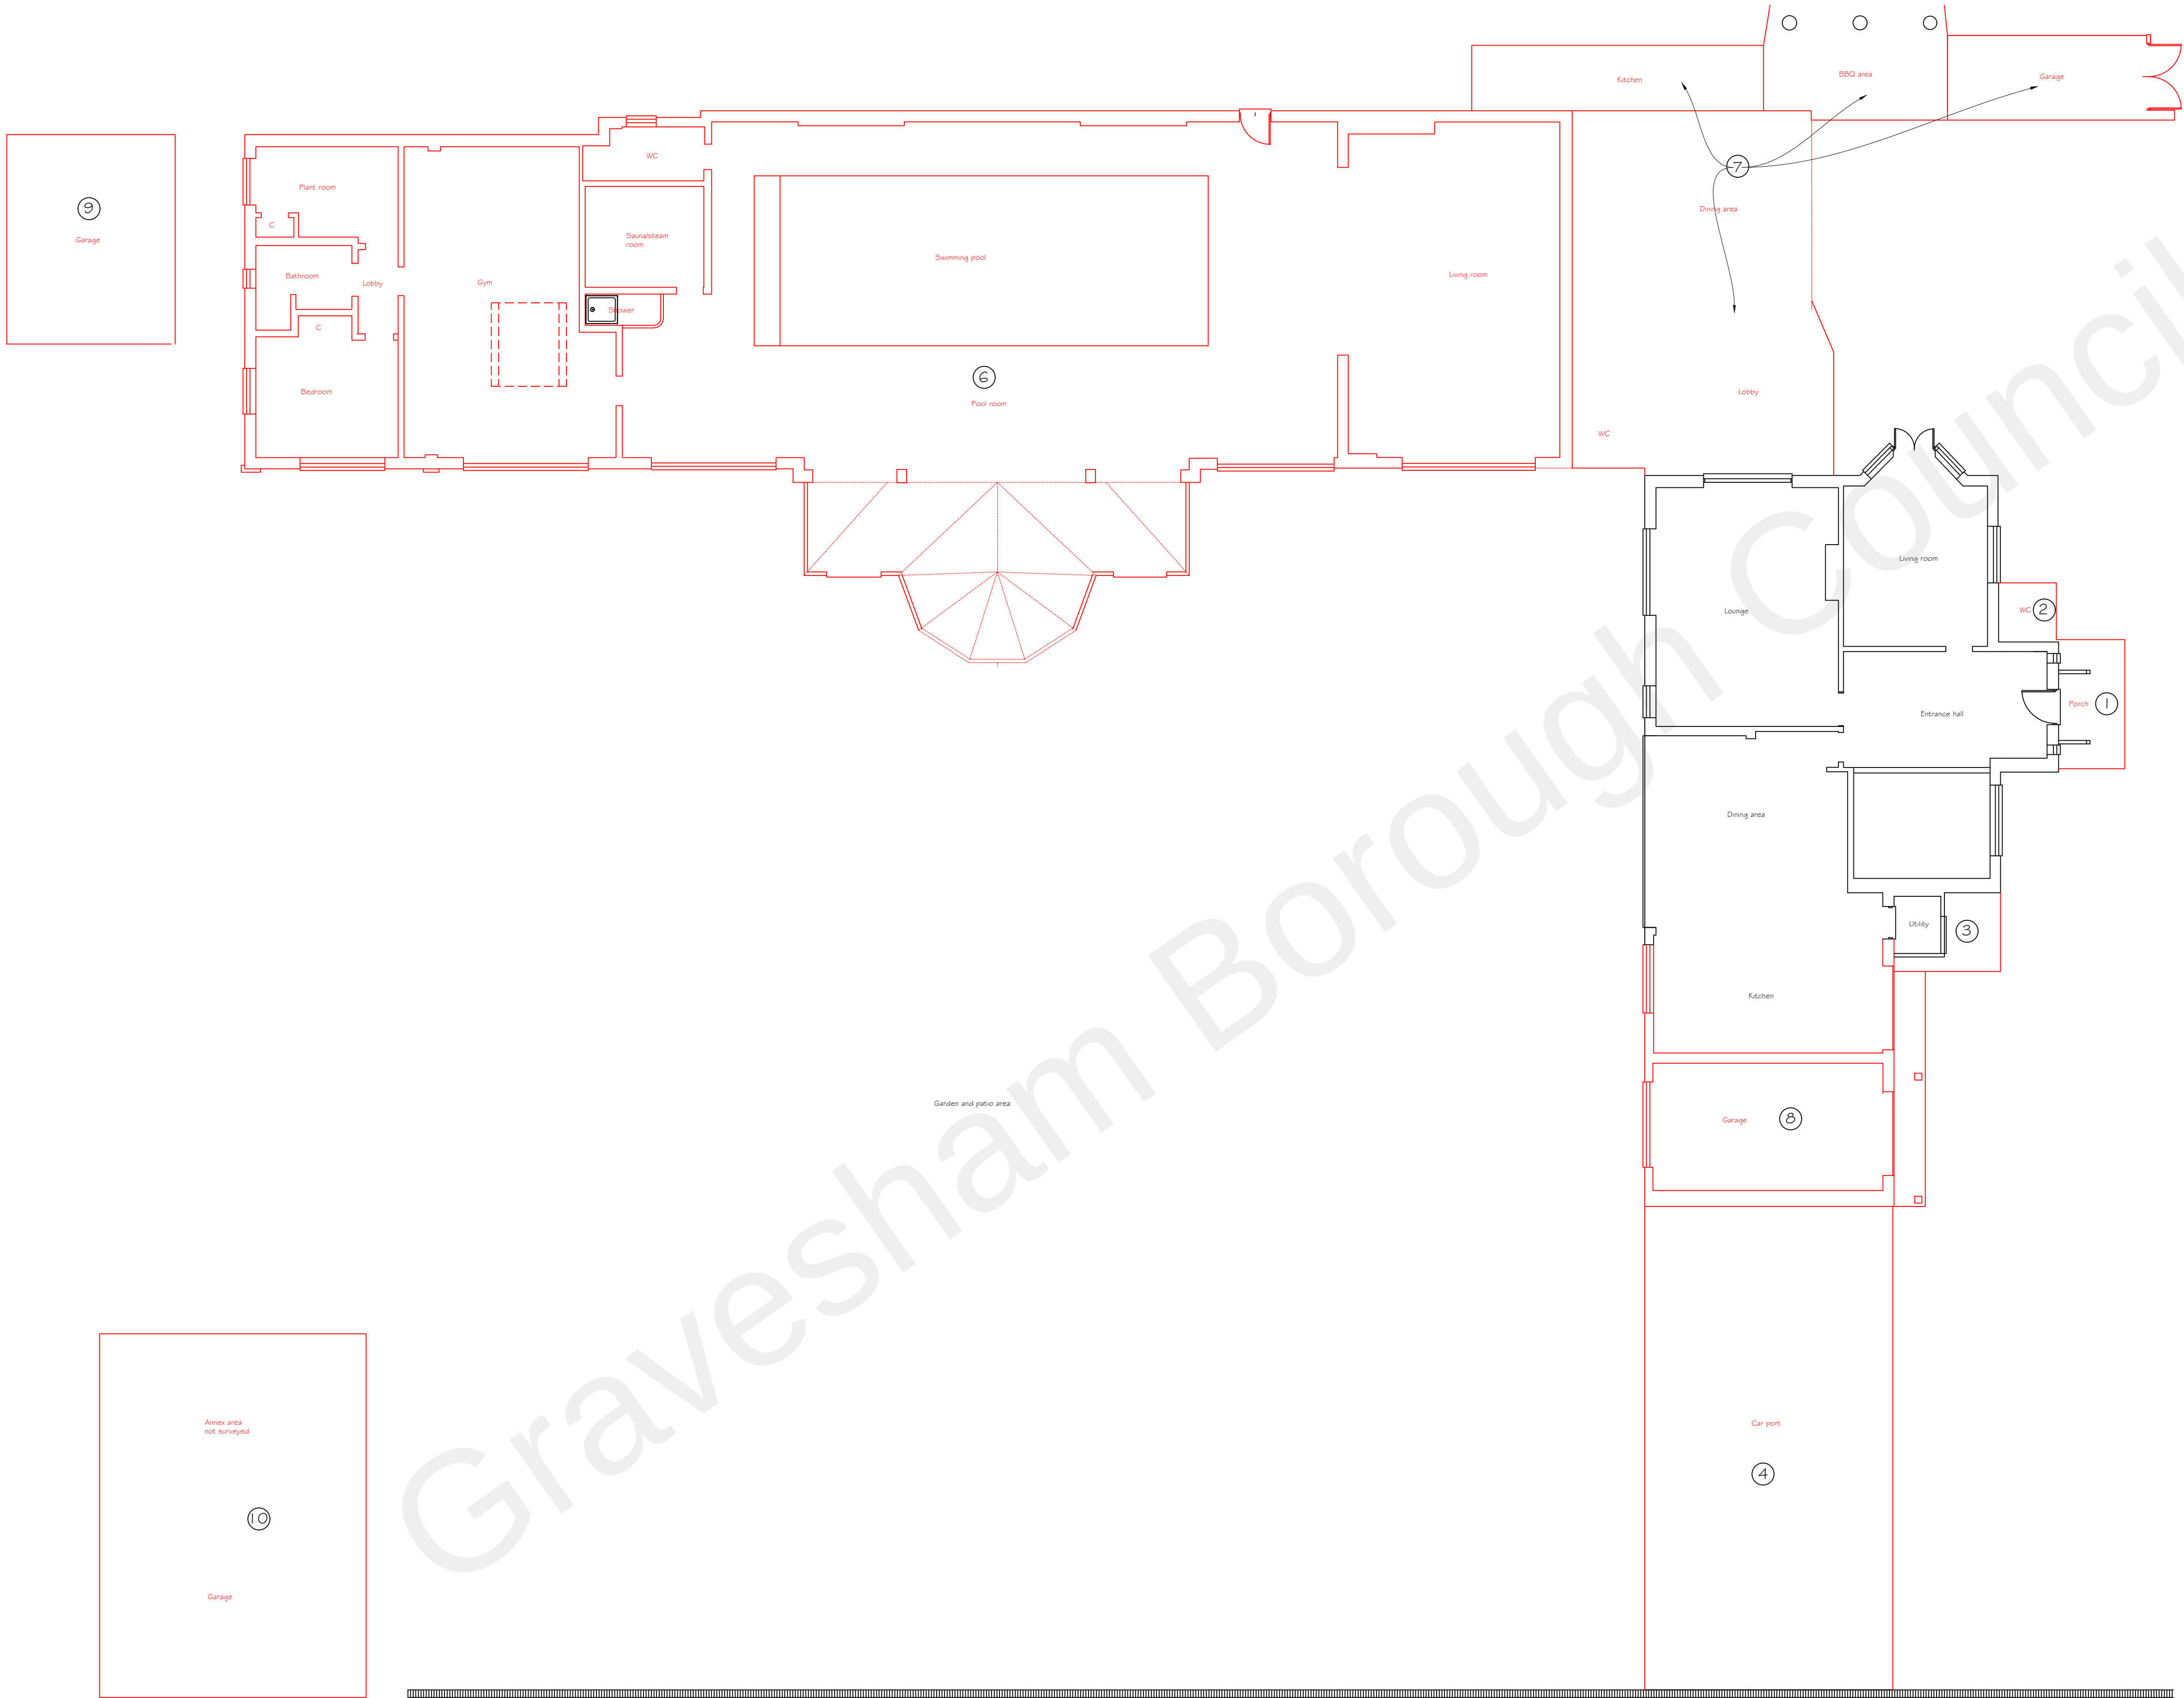

First floor outline plan
Scale 1:100

Ground floor plan

Scale 1:100

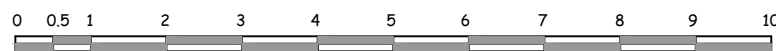

Rev B- Additional information added.
Rev A- Red line highlight added.

13 October 2022
6 October 2022

Synergy Planning & Property Consultants Ltd The Office The Larches Rochester Kent ME3 7NQW		
Client	Mrs Mattu	
Address	The Orchards Higham Kent	
Drawing title	Floor plan post 2009	
Scale	1:100	
Date	30 July 2022	Drawn by
Drawing No	22/380/04	B