



- Do not scale from this drawing.
- All dimensions to be verified on site and is in mm.
- Builder to verify all dimensions, heights and levels prior to commencement of work.
- All documents shall be checked to ensure that they are compatible by the contractor before construction commences. In the event of apparent ambiguity or contradiction the engineer and/ or architect shall be notified immediately.
- The contractor in preparing his estimate shall visit the site and acquaint himself with the problems involved.
- The contractor shall issue all statutory notices to the local Authority during progress completion of works.

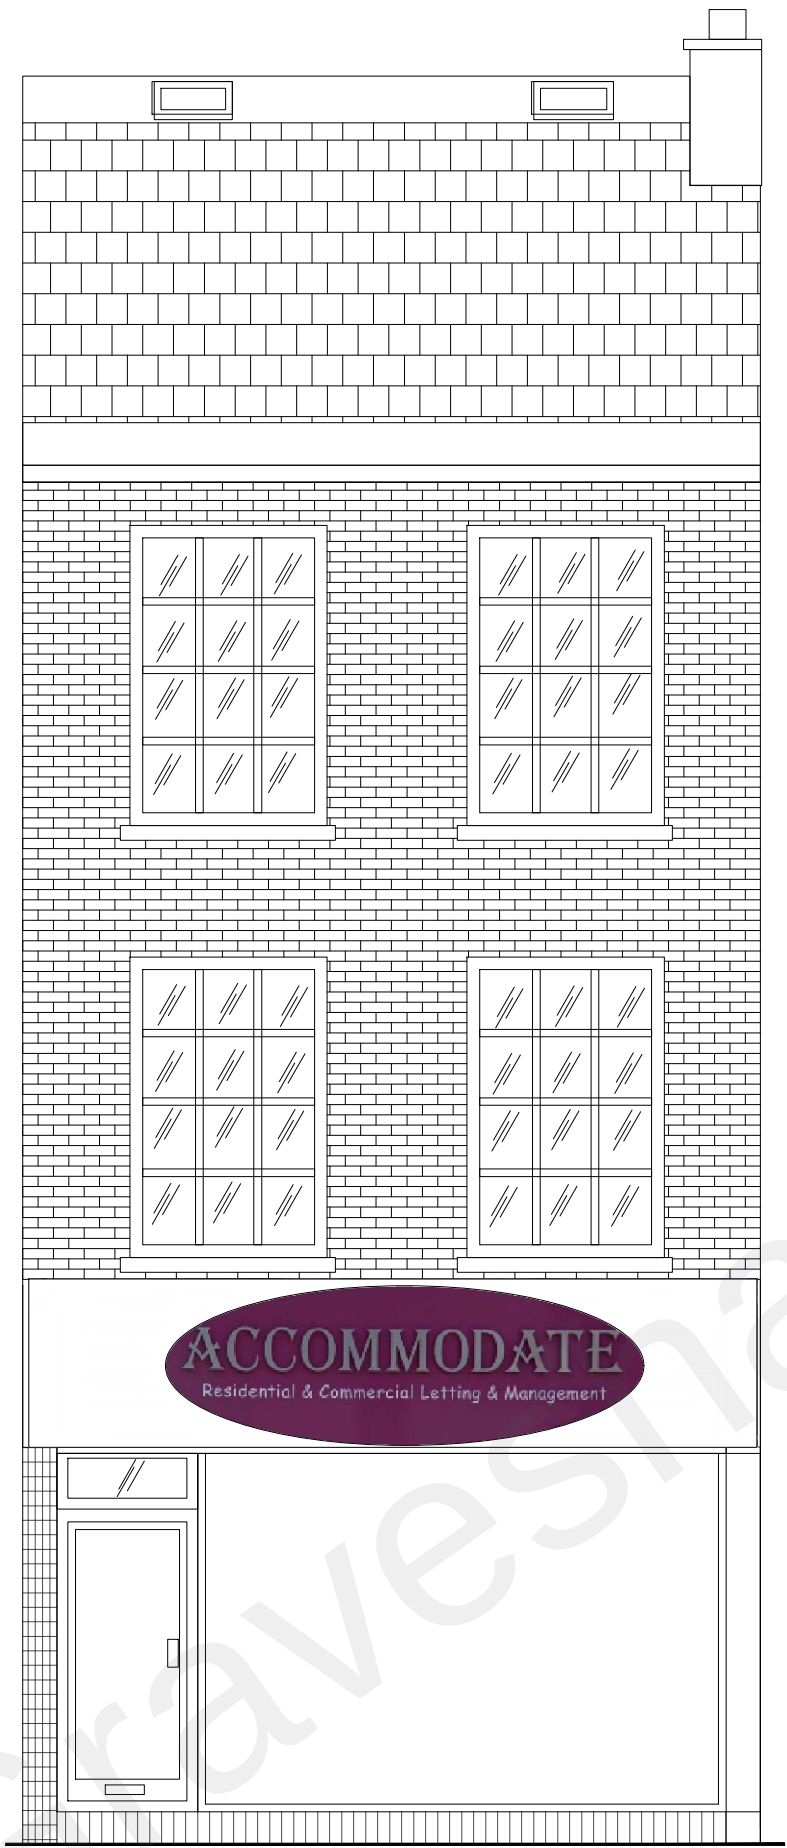

Pre-Existing Front Elevation

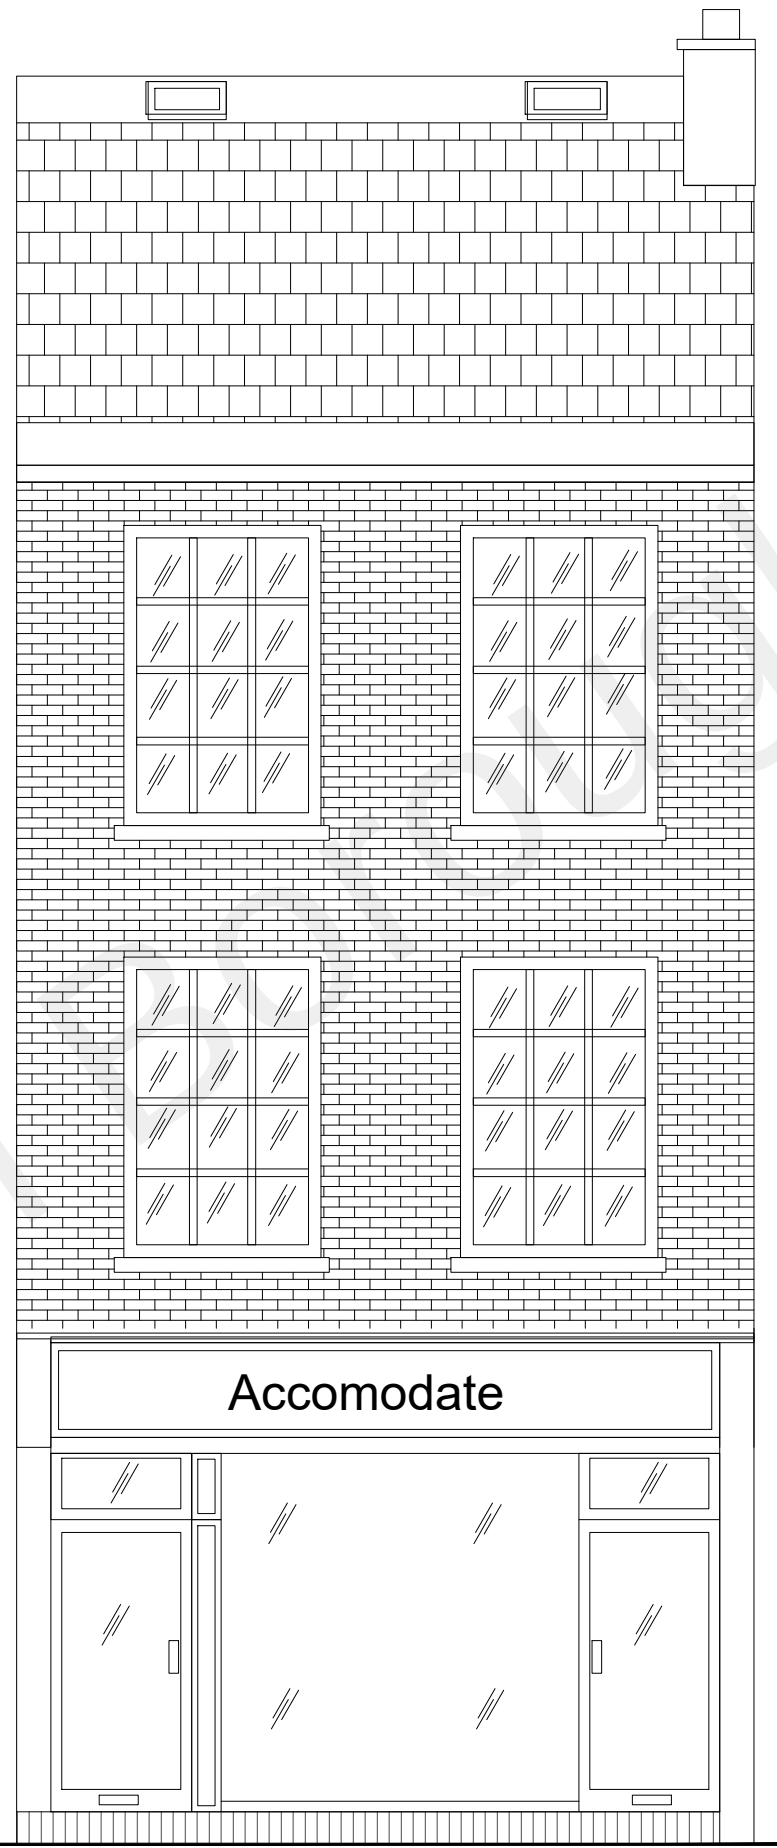

Existing Front Elevation(as built)



|      |              |     |       |
|------|--------------|-----|-------|
| A    | -            | -   | -/-/- |
| REV: | DESCRIPTION: | BY: | DATE: |

STATUS: PLANNING

BARRON  
EDWARDS  
STERLING

Whitehall Place  
47 The Terrace,  
Gravesend, Kent  
DA12 2DL  
01474 247 787  
info@barronedwards.co.uk  
www.barronedwards.co.uk

SITE:  
163 Windmill Street  
Gravesend  
Kent  
DA12 1AH

TITLE:  
Elevations  
-----  
-----

|                       |                     |                 |
|-----------------------|---------------------|-----------------|
| SCALE AT A2:<br>1:50  | DATE:<br>01/03/2023 | DRAWN:<br>HH/GK |
| PROJECT NO:<br>220202 | DRAWING NO:<br>003  | REVISION:<br>A  |