


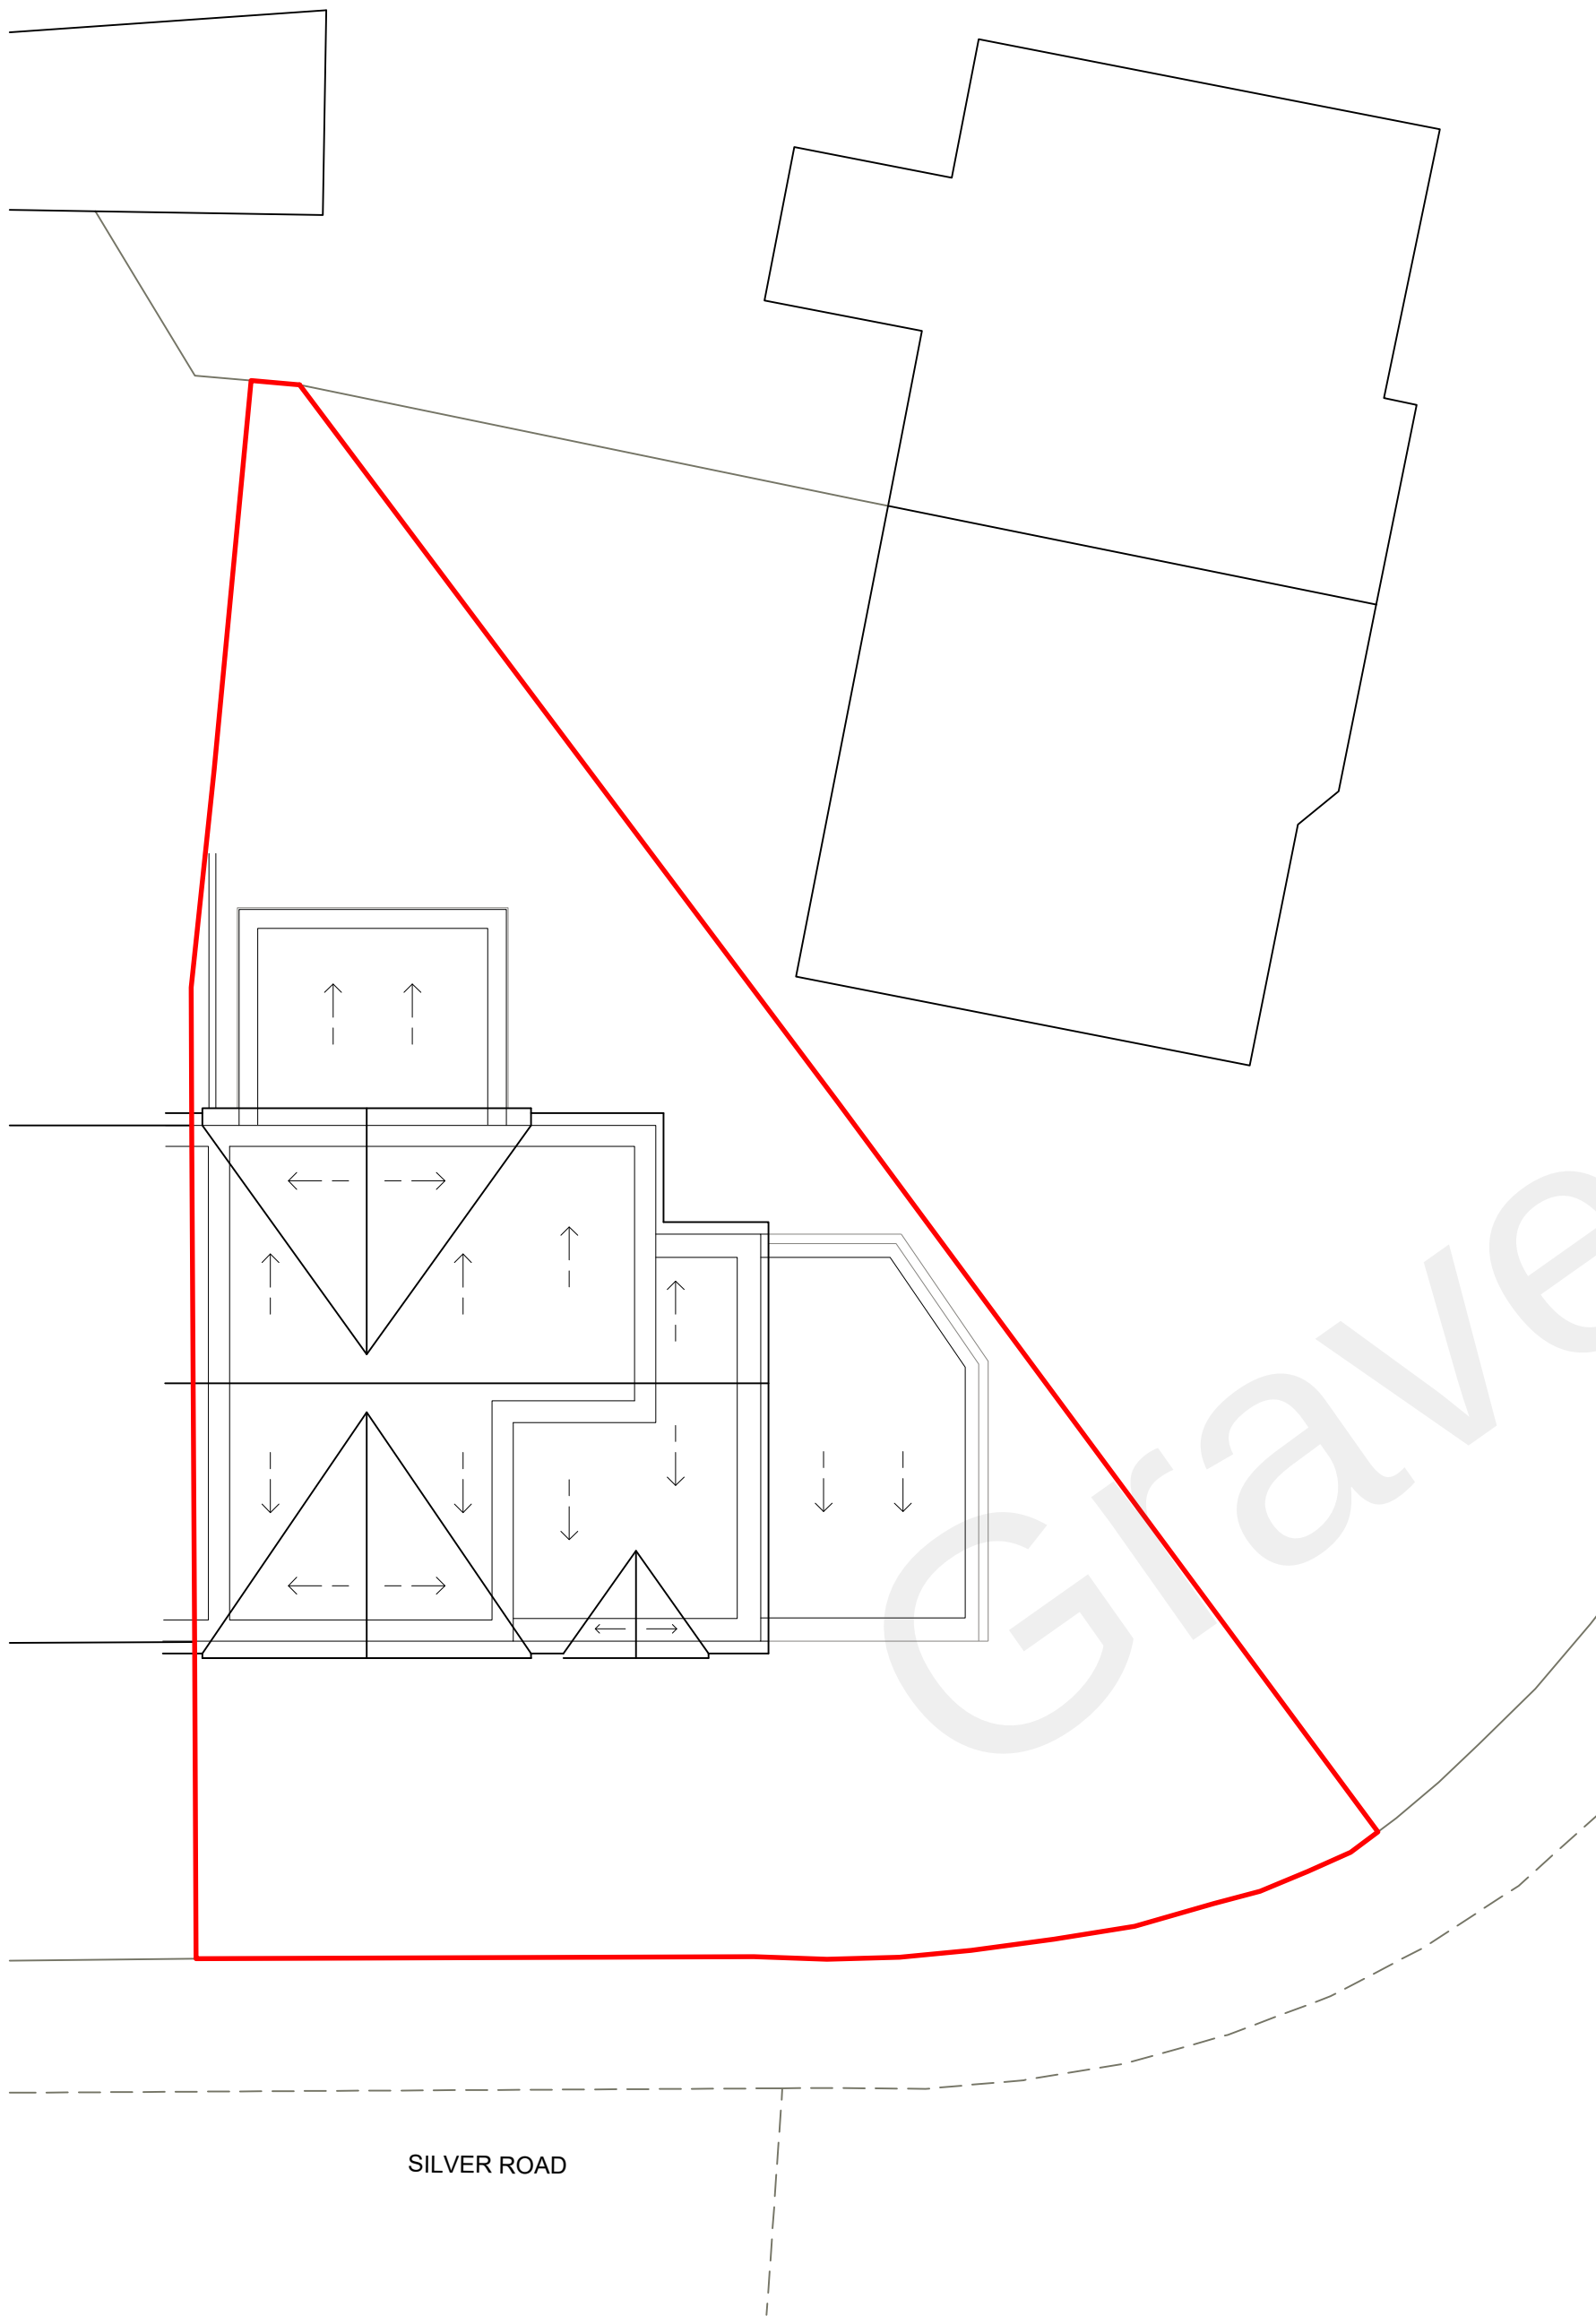
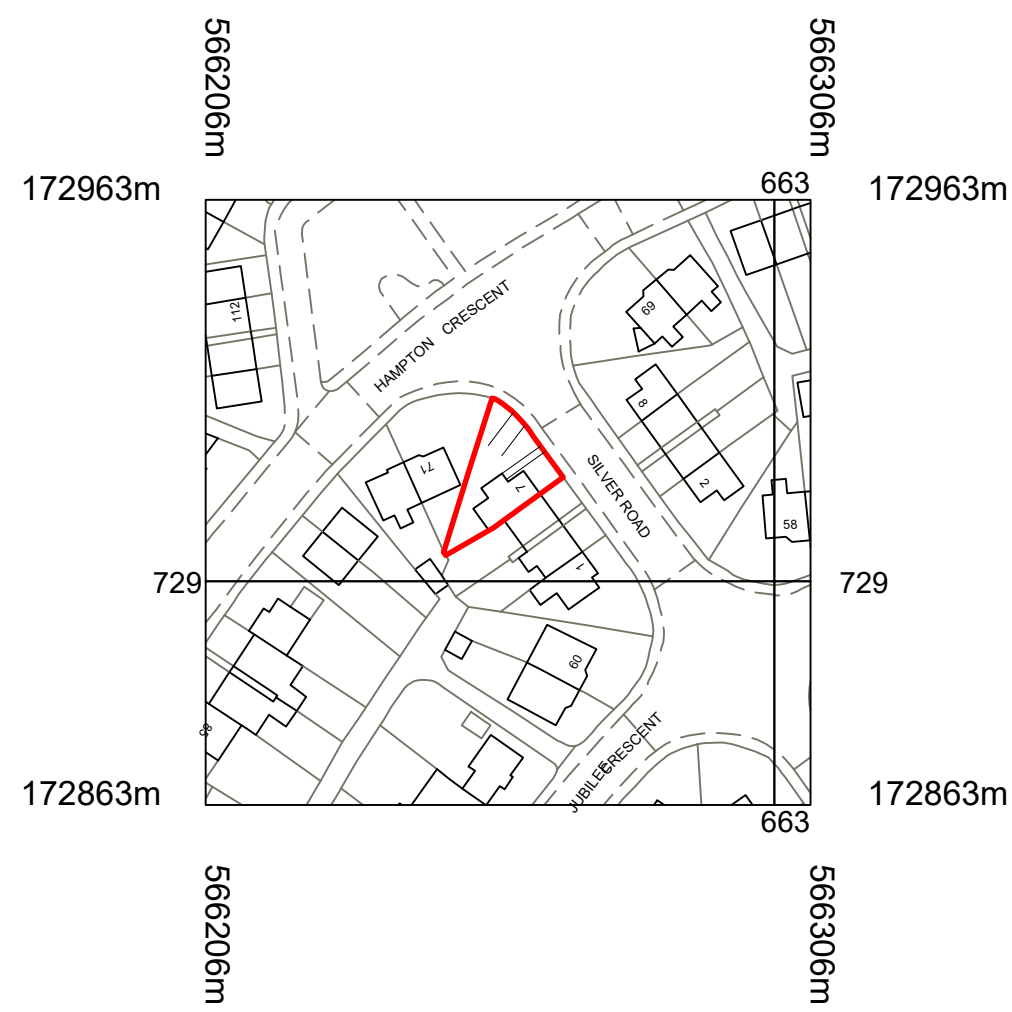


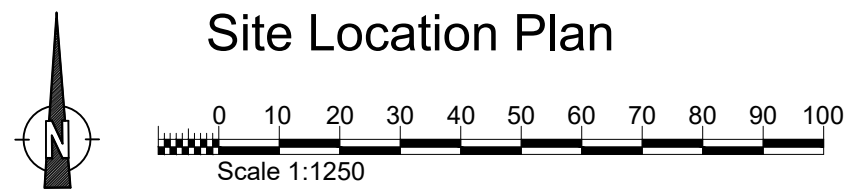

Block Plan @ 1:100

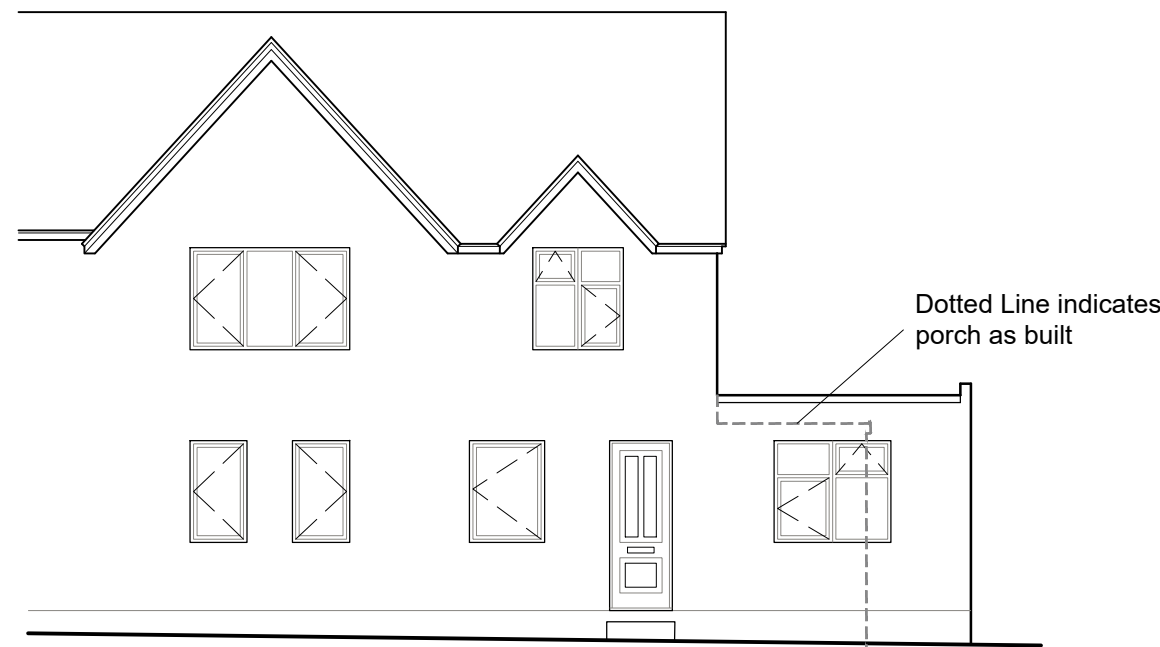


Front Elevation (E)

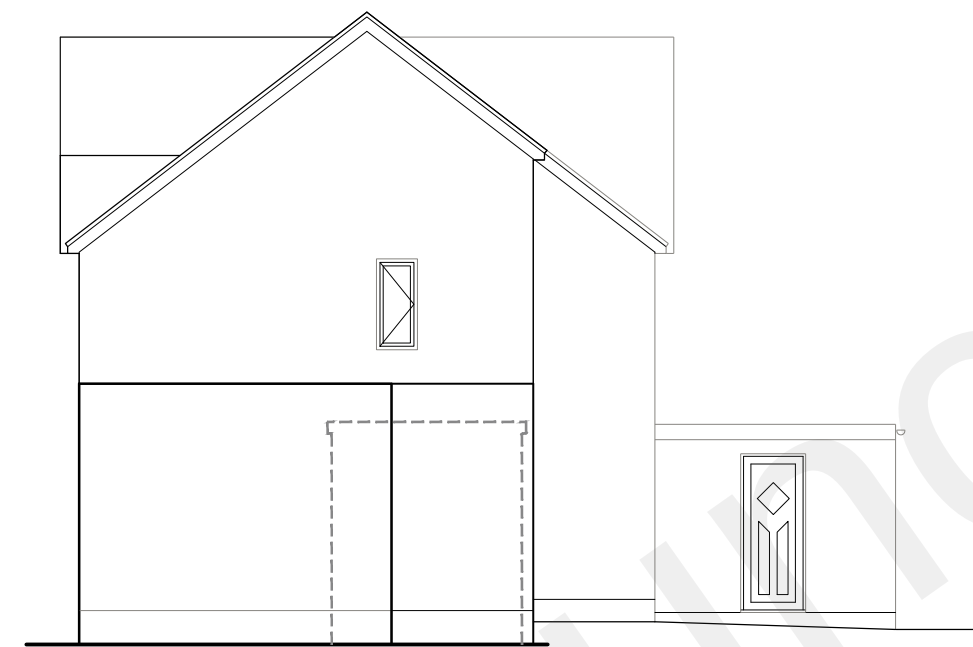


Side Elevation (N)




Rear Elevation (W)

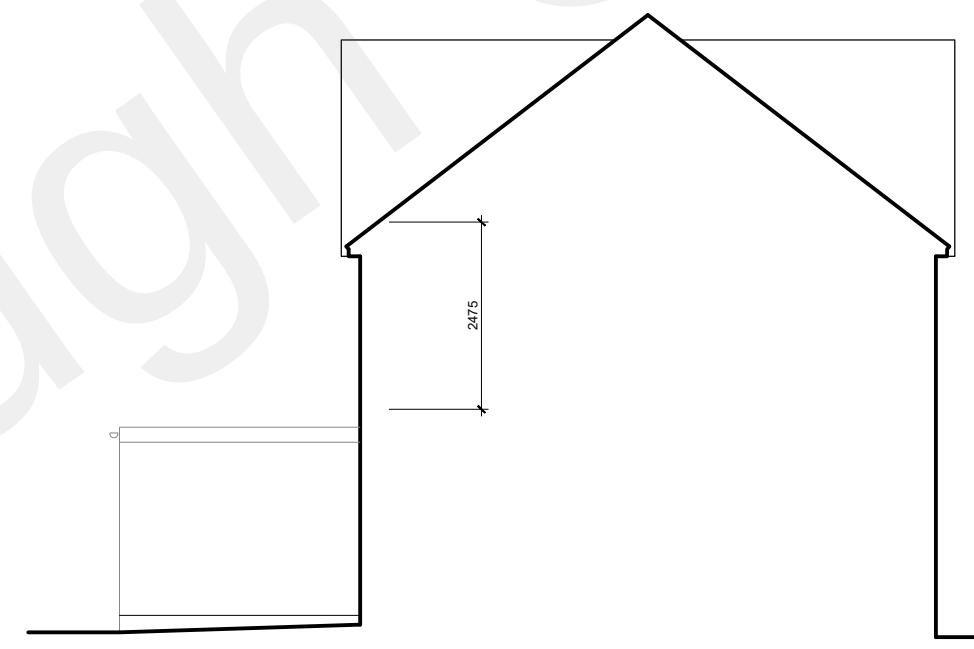


Side Elevation (S)

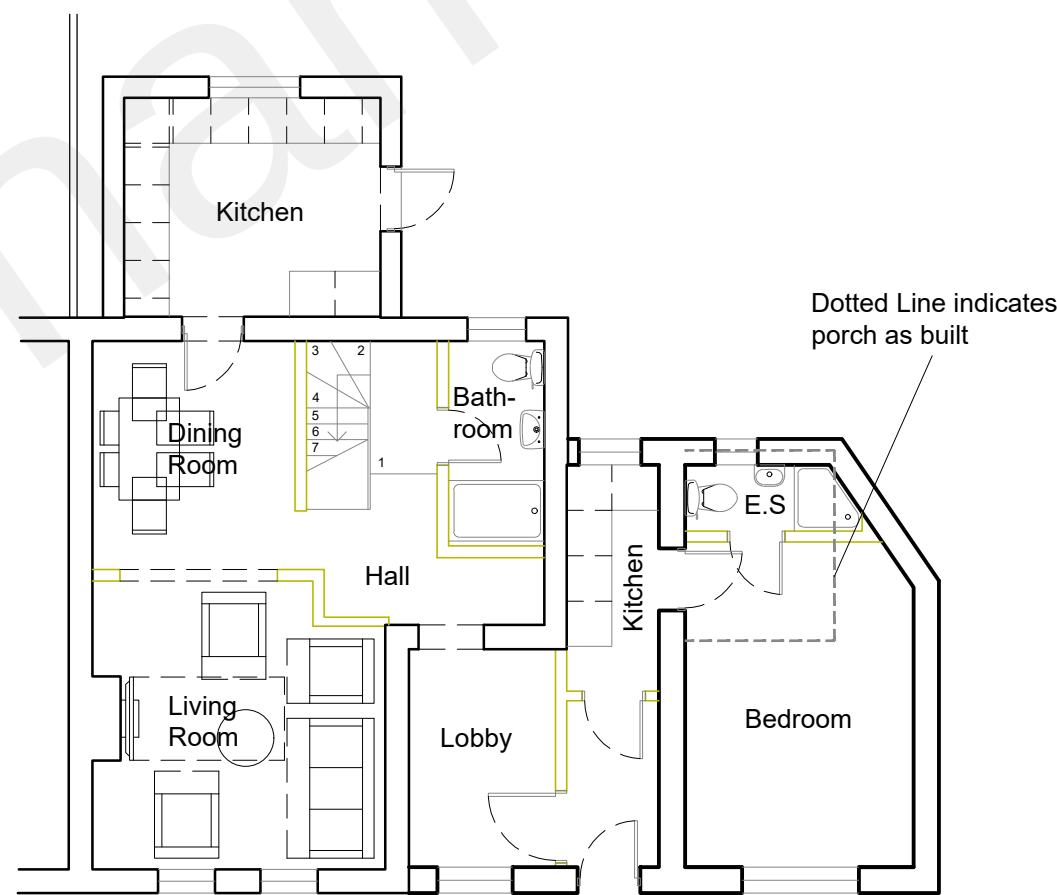


Ground Floor Plan

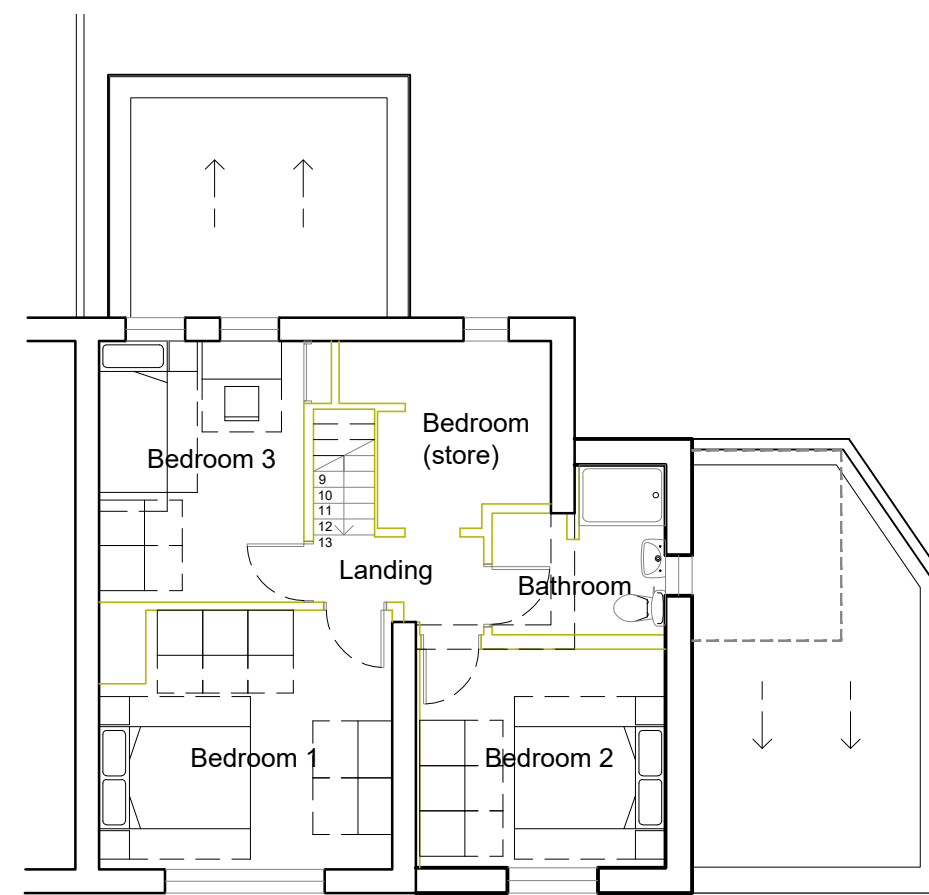


First Floor Plan

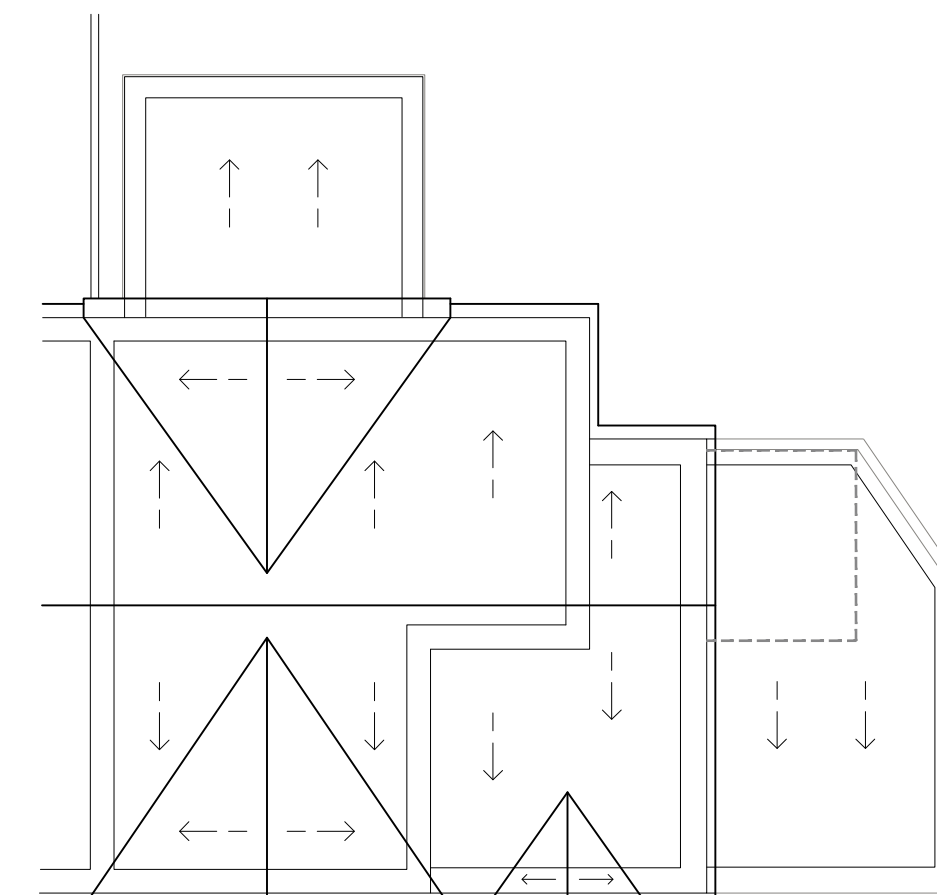

Roof Plan

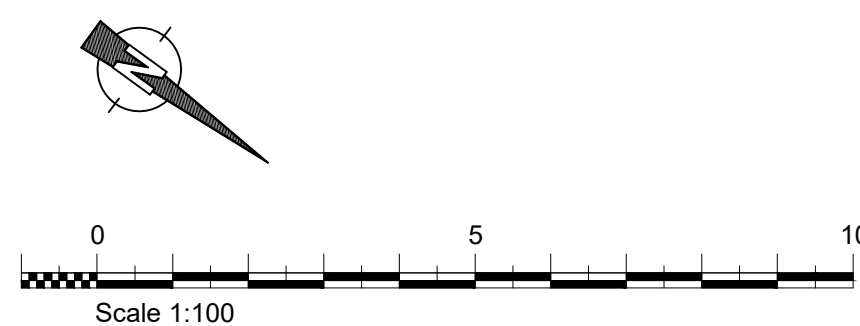

This drawing remains the Copyright of the architects and may not be reproduced in whole or in part without their written permission

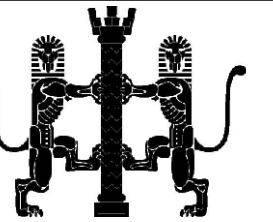

NOTES

Do not scale

Verify all dimensions on site before commencing any work or preparing any shop drawings

All building materials, components and workmanship to comply with the appropriate Public Health Acts, Building Regulations, British & European Standards and Codes of Practice and to the appropriate manufacturers recommendations.

For all specialist work see relevant drawings

All schemes to be set out completely including buildings, roads, drainage and levels prior to the commencement of works

Sites to be checked against Land Registry plans and any necessary Easements to be established

Any discrepancies, errors or omissions to be reported to the architect for further instructions before commencement of works

K		
J		
H		
G		
F		
E		
D		
C		
B		
A	Porch 'as Built' indicated on plans	AS
06.12.21		
Date	Revisions	By

DAC
Architects

21 Stone Street, Gravesend, Kent, DA11 0NP
Tel: 01474 566996 Fax: 01474 320374
Design@DACarchitects.co.uk

Project Title

**7 Silver Road
Gravesend
Kent
DA12 4JB**

Client

Mr + Mrs Ifeanyi Onyema

Drawing Title

As Existing

Scale	Date	Drawn By
1:100 & 1:1250	27.09.2018	LW

Project No.	Dwg. No.	Rev.
5165	PL-01	