




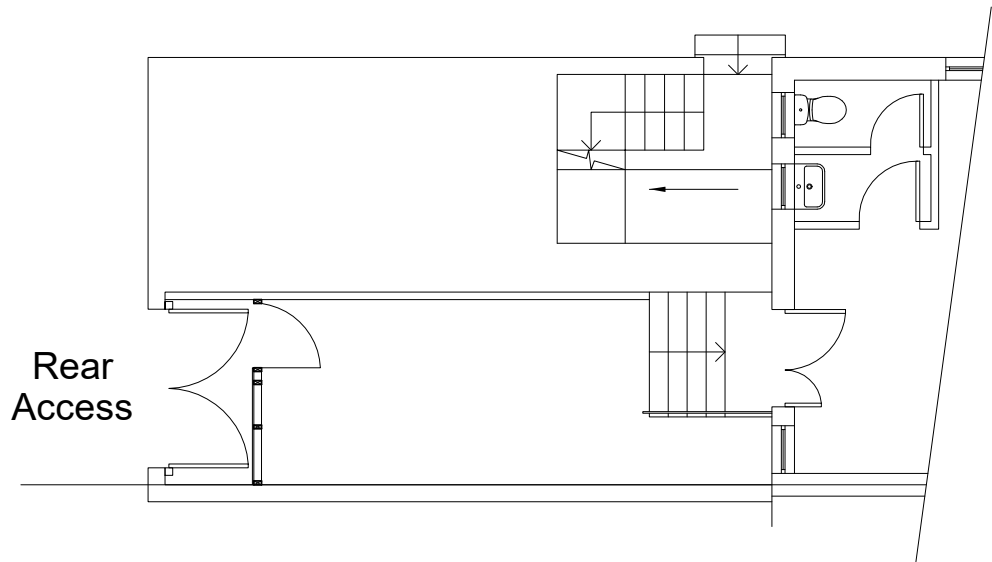


Ground Floor Plan (As Built)
1:100

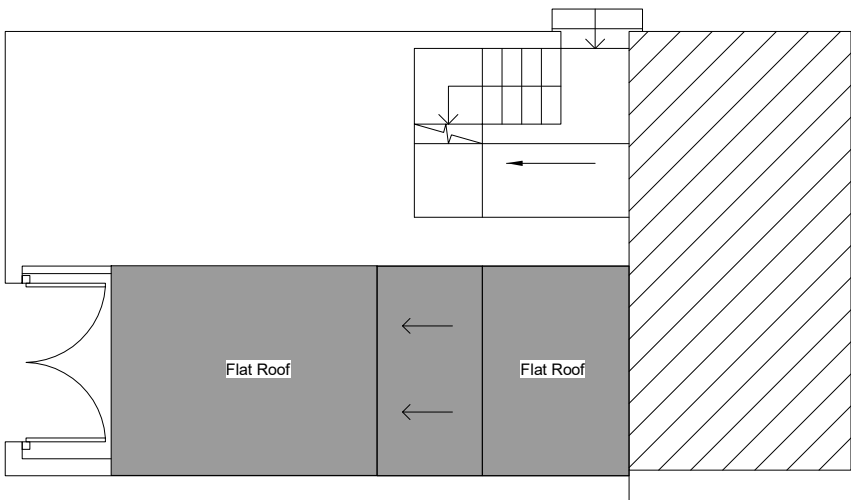


Roof Plan (As Built)
1:100

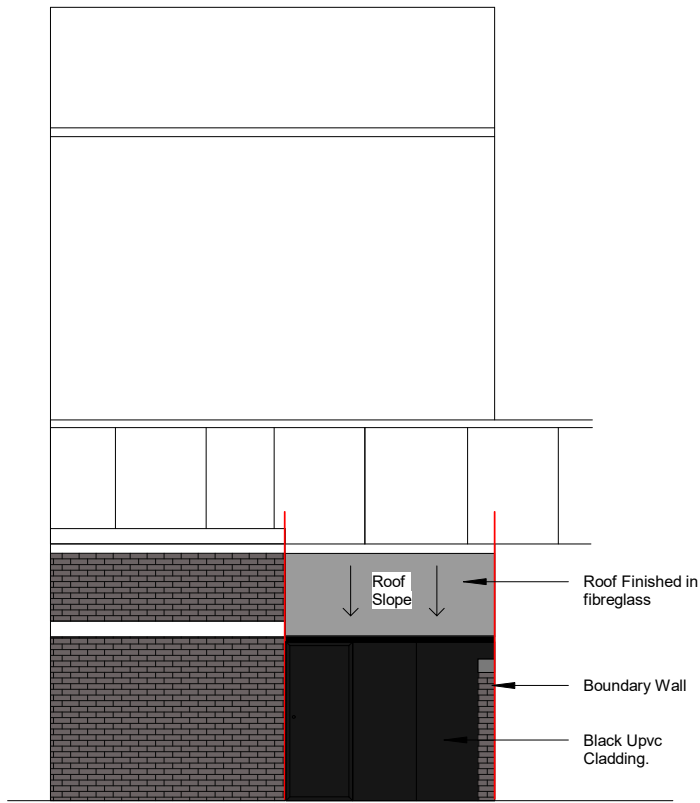

Rear Elevation (As Built)
1:100

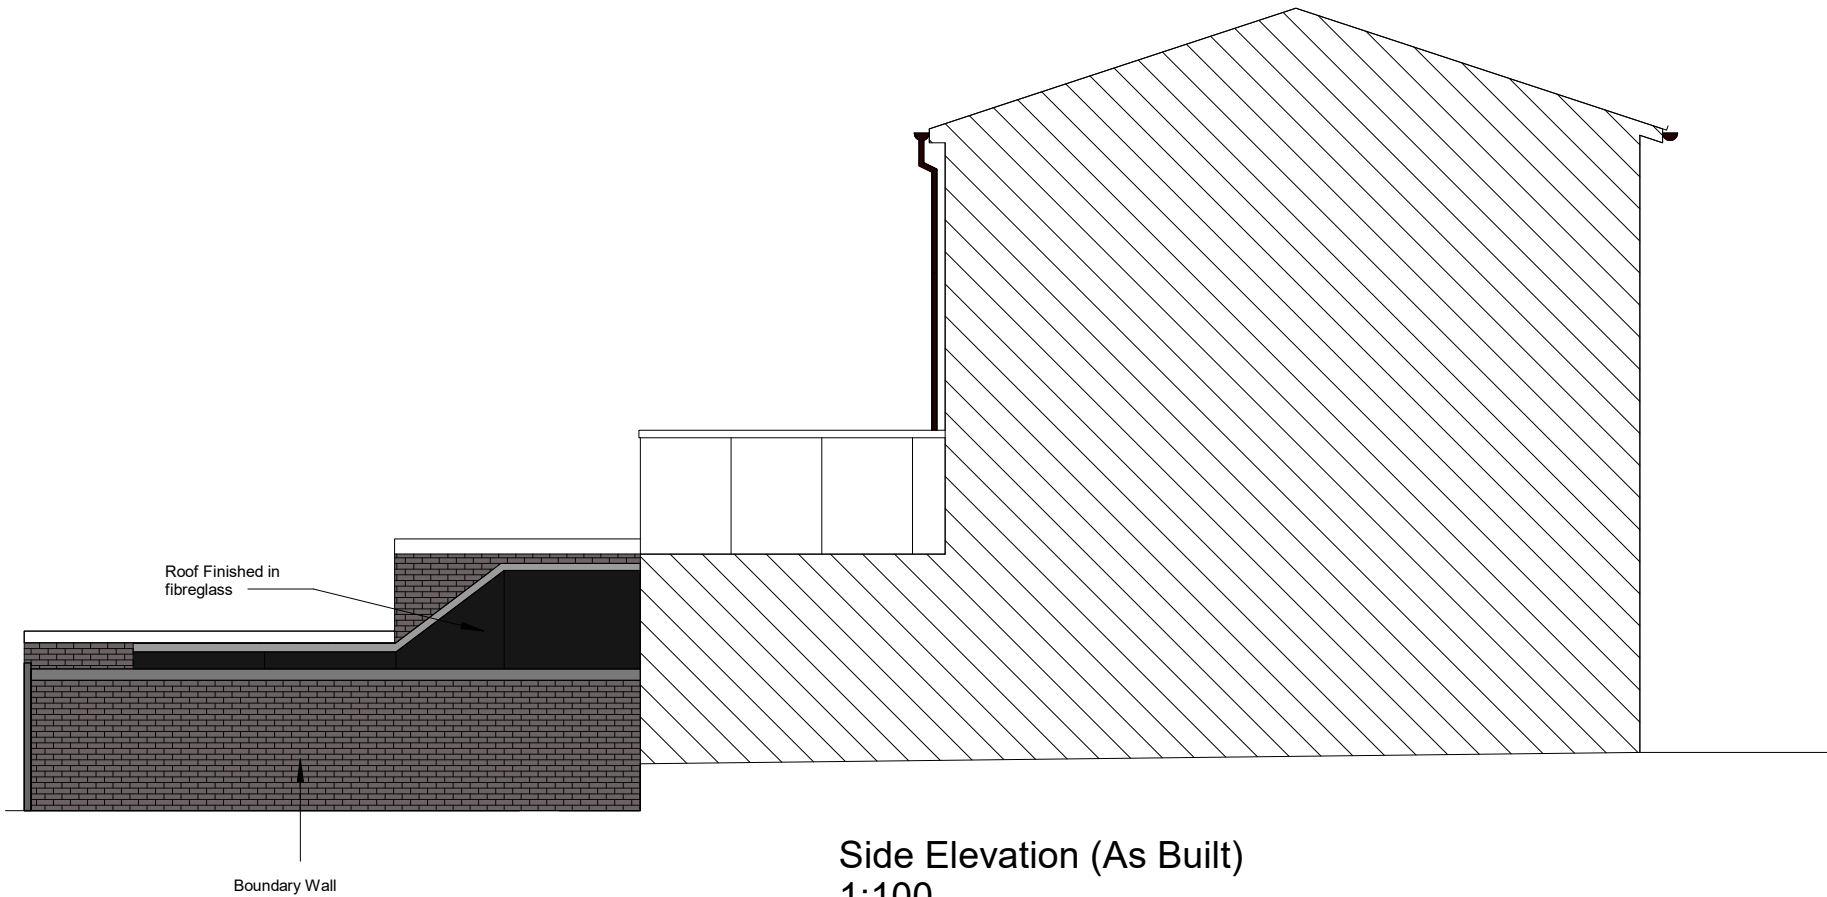

Side Elevation (As Built)
1:100

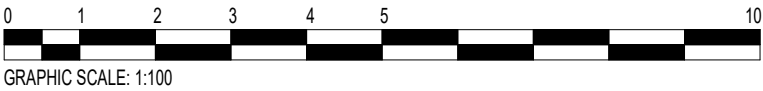

No	Description	Date	8 The Hive, Northfleet, Gravesend DA11 9DE		Client	REF	REV
					Mr S Kumar		
			(As Built) Plans and Elevations		Date DEC 2024	Sheet number PL/8TH/02/SD101	Scale (@ A3) 1 : 100
					Drawn MMK	Sanaa Designs Email - sanaadesigns@outlook.com Mobile - 07583 437570	
					Checked by TK		