

CURRENT & PROPOSED BLOCK PLAN GROUND FLOOR
SCALE 1:200
SITE BOUNDARY MARKED WITH RED LINE

KEY


COMMERCIAL USE

PRIVATE USE

WC


CIRCULATION

EXTERNAL AMMENITY

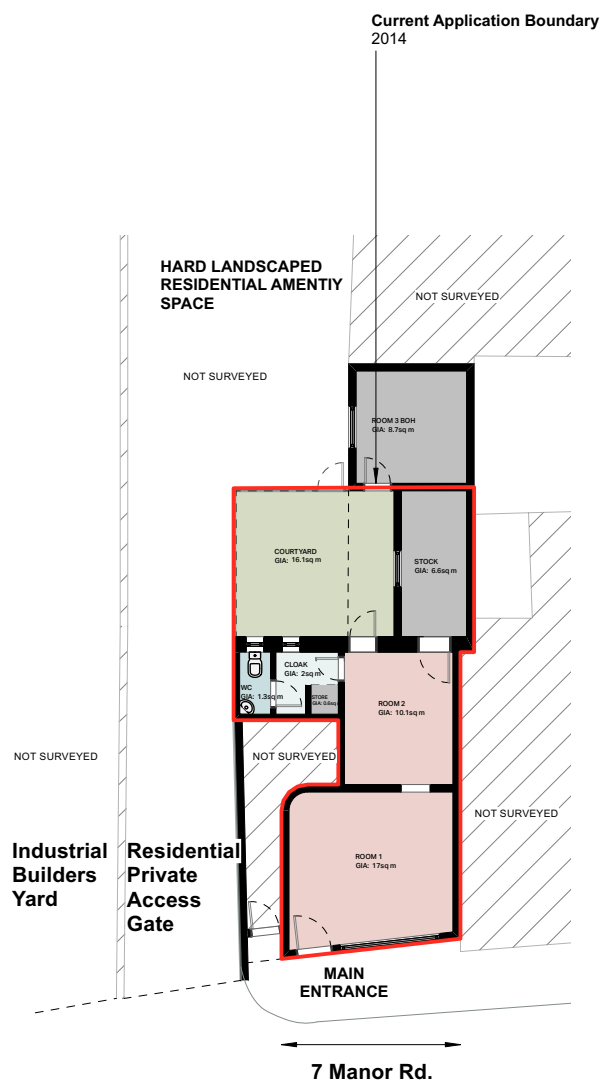


MANOR ROAD

EXISTING BLOCK PLAN
APPLICATION GRANTED 2014 REF 20140465

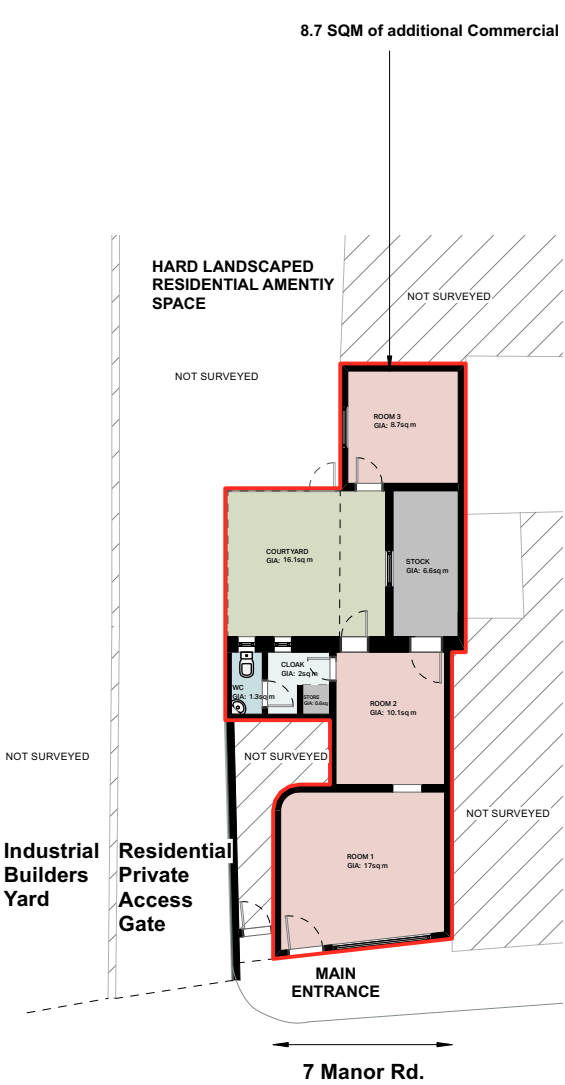

MANOR ROAD

PROPOSED BLOCK PLAN
COMMERCIAL AREAS REVISED 8.7 ADDITIONAL SQM

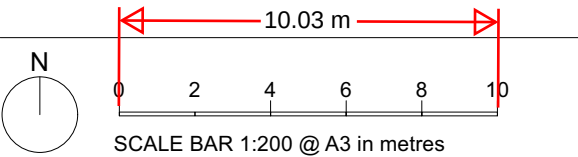

PURPOSE: FOR PLANNING PERMISSION	
PROJECT: COMPASS ALEHOUSE	TITLE: BLOCK FLOOR PLANS
ADDRESS: 7 MANOR RD, GRAVESEND, KENT. DA12 1AA	DRAWING No. 01-04-001
	SCALE: 1:200
	PAGE SIZE: A3
	DRAWN BY: RC
	DATE: 21/09/24
	REVISION: B