

Delegated Report

Lawful Development Certificate (Proposed)

Application no:	20220331
Location	20 Hardy Avenue Northfleet Gravesend Kent
Proposal:	Application for Lawful Development Certificate for proposed construction of a dormer extension in the rear roof slope and conversion of loft to habitable rooms.
Applicant:	Mr Manjinder Singh
Site Visit	N/A Desktop Assessment

Plans & Documents

Application Form Dated 21/03/2022;
Site Location Plan – Revised;
Block Plan; and
Drawing no. RS/239/HA/22 (Rev 1) (Revised - Elevations - Existing and Proposed; Roof Plan - Existing and Proposed and Floor Plans - Existing and Proposed).

~~Site Location Plan~~
~~Drawing no. RS/239/HA/22 (Elevations and Floor Plans – Existing and Proposed – Revised)~~
~~Drawing no. RS/239/HA/22 (Elevations and Floor Plans – Existing and Proposed)~~

Property Type

20 Hardy Avenue is a two-storey semi-detached dwellinghouse.

Material Consideration


Town and Country Planning (General Permitted Development) (England) Order 2015 (as amended)

Relevant Planning History

20180879	Single storey rear extension with a depth of 6 metres, maximum height of 3 metres and eaves height of 2.5 metres.	R1- Prior Approval Not Required	04.10.2018
----------	---	---------------------------------	------------

Plan Note

There are some discrepancies with the elevations shown on drawing no. RS/239/HA/22. However, the agent has clearly shown the rear dormer to be set in 0.3m from the eaves, measured along the roof slope from the outside edge, as illustrated in the Permitted Development Rights for Householders – Technical Guidance.

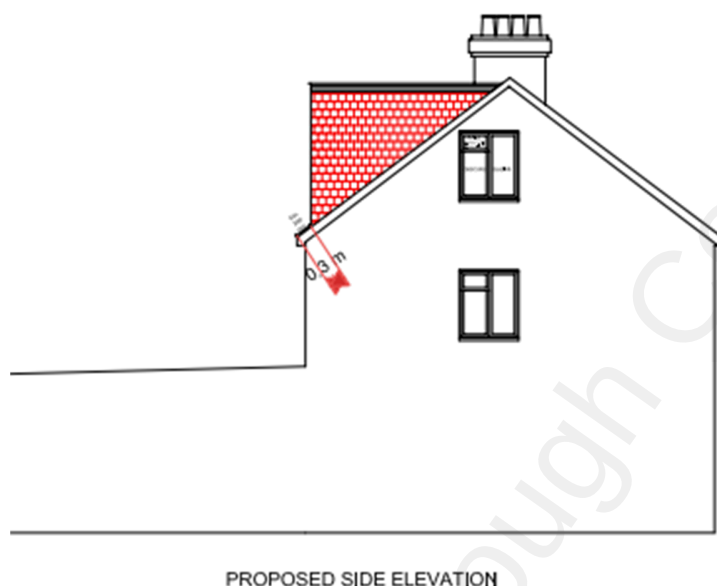

Officer Assessment

Permitted Developments Rights Restrictions

Article 2 (3) Land (AONB, Conservation Area)	N
Article 4 Direction	N
Permitted Development Rights Removed/Restricted	N

Class B - The enlargement of a dwellinghouse consisting of an addition or alteration to its roof.

B.1	Development is not permitted by Class B if –	Y/N
(a)	Permission to use the dwellinghouse as a dwellinghouse has been granted only by virtue of Class M, N, P, PA or Q of Part 3 of this Schedule (changes of use);	N
(b)	Any part of the dwellinghouse would, as a result of the works, exceed the height of the highest part of the existing roof;	N
(c)	Any part of the dwellinghouse would, as a result of the works, extend, beyond the plane of any existing roof slope which forms the principal elevation of the dwellinghouse and fronts a highway;	N
(d)	The cubic content of the resulting roof space would exceed the cubic content of the	

	original roof space by more than – (i) 40 cubic metres in the case of a terrace house, or (ii) 50 cubic metres in any other case;	N 38.66m3 N
(e)	It would consist of or include – the construction or provision of a verandah, balcony or raised platform or the installation, alteration or replacement of a chimney, flue or soil and vent pipe; or	N N
(f)	The dwellinghouse is on article 2 (3) land	N
B.2	Development is permitted by Class B subject to the following conditions –	Y/N
(a)	The materials used in any exterior work must be of a similar appearance to those used in the construction of the exterior of the existing dwellinghouse;	Y
(b)	The enlargement must be constructed so that – (i) other than in the case of a hip-to-gable enlargement or an enlargement which joins the original roof to the roof of a rear or side – extension (aa) the eaves of the original roof are maintained or reinstated; and (bb) the edge of the enlargement closest to the eaves of the original roof is, so far as practicable, not less than 0.2 metres from the eaves, measured along the roof slope from the outside edge of the eaves; and (ii) other than in the case of an enlargement which joins the original roof to the roof of a rear or side extension, no part of the enlargement extends beyond the outside face of any external wall of the original dwelling house; and	Y Y 0.3m N
(c)	Any window inserted on a wall or roof slope forming a side elevation of the dwellinghouse must be – (i) obscure-glazed, and (ii) non-opening unless the parts of the window which can be opened are more than 1.7 metres above the floor of the room in which the window is installed.	Y Y

Class C - Any other alteration to the roof of a dwellinghouse.


C.1	Development is not permitted by Class C if -	Y/N
(a)	permission to use the dwelling as a dwellinghouse has been granted only by virtue of Class M, N, P, PA or Q of Part 3 of this Schedule (changes of use);	N/A
(b)	the alteration would protrude more than 0.15 metres beyond the plane of the slope of the original roof when measured from the perpendicular with the external surface of the	N

	original roof;	
(c)	it would result in the highest part of the alteration being higher than the highest part of the original roof;	N
(d)	it would consist of or include – (i) the installation, alteration or replacement of a chimney, flue or soil and vent pipe, or (ii) the installation, alteration or replacement of solar photovoltaics or solar thermal equipment.	N N
C.2	Development is permitted by Class C subject to the condition that any window located on a roof slope forming a side elevation of the dwellinghouse must be- (a) obscure-glazed; and (b) non-opening unless the parts of the window which can be opened are more than 1.7 metres above the floor of the room in which the window is installed.	Y Y

Conclusion

The proposed development complies with Schedule 2, Part 1, Class B and Class C of **THE TOWN AND COUNTRY PLANNING (GENERAL PERMITTED DEVELOPMENT) (ENGLAND) ORDER 2015, AS AMENDED**, and the **LAWFUL DEVELOPMENT CERTIFICATE** is **GRANTED**.

Recommendation: Grant Lawful Development Certificate

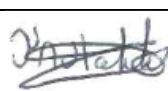Case Officer:	Mrs Nina Goodbody	Team Leader:	Miss Faye Hobbs
Signed:	<i>N Goodbody</i>	Signed:	
Dated:	21st June 2022	Dated:	21 June 2022