





SECTION A-A. Scale 1:200

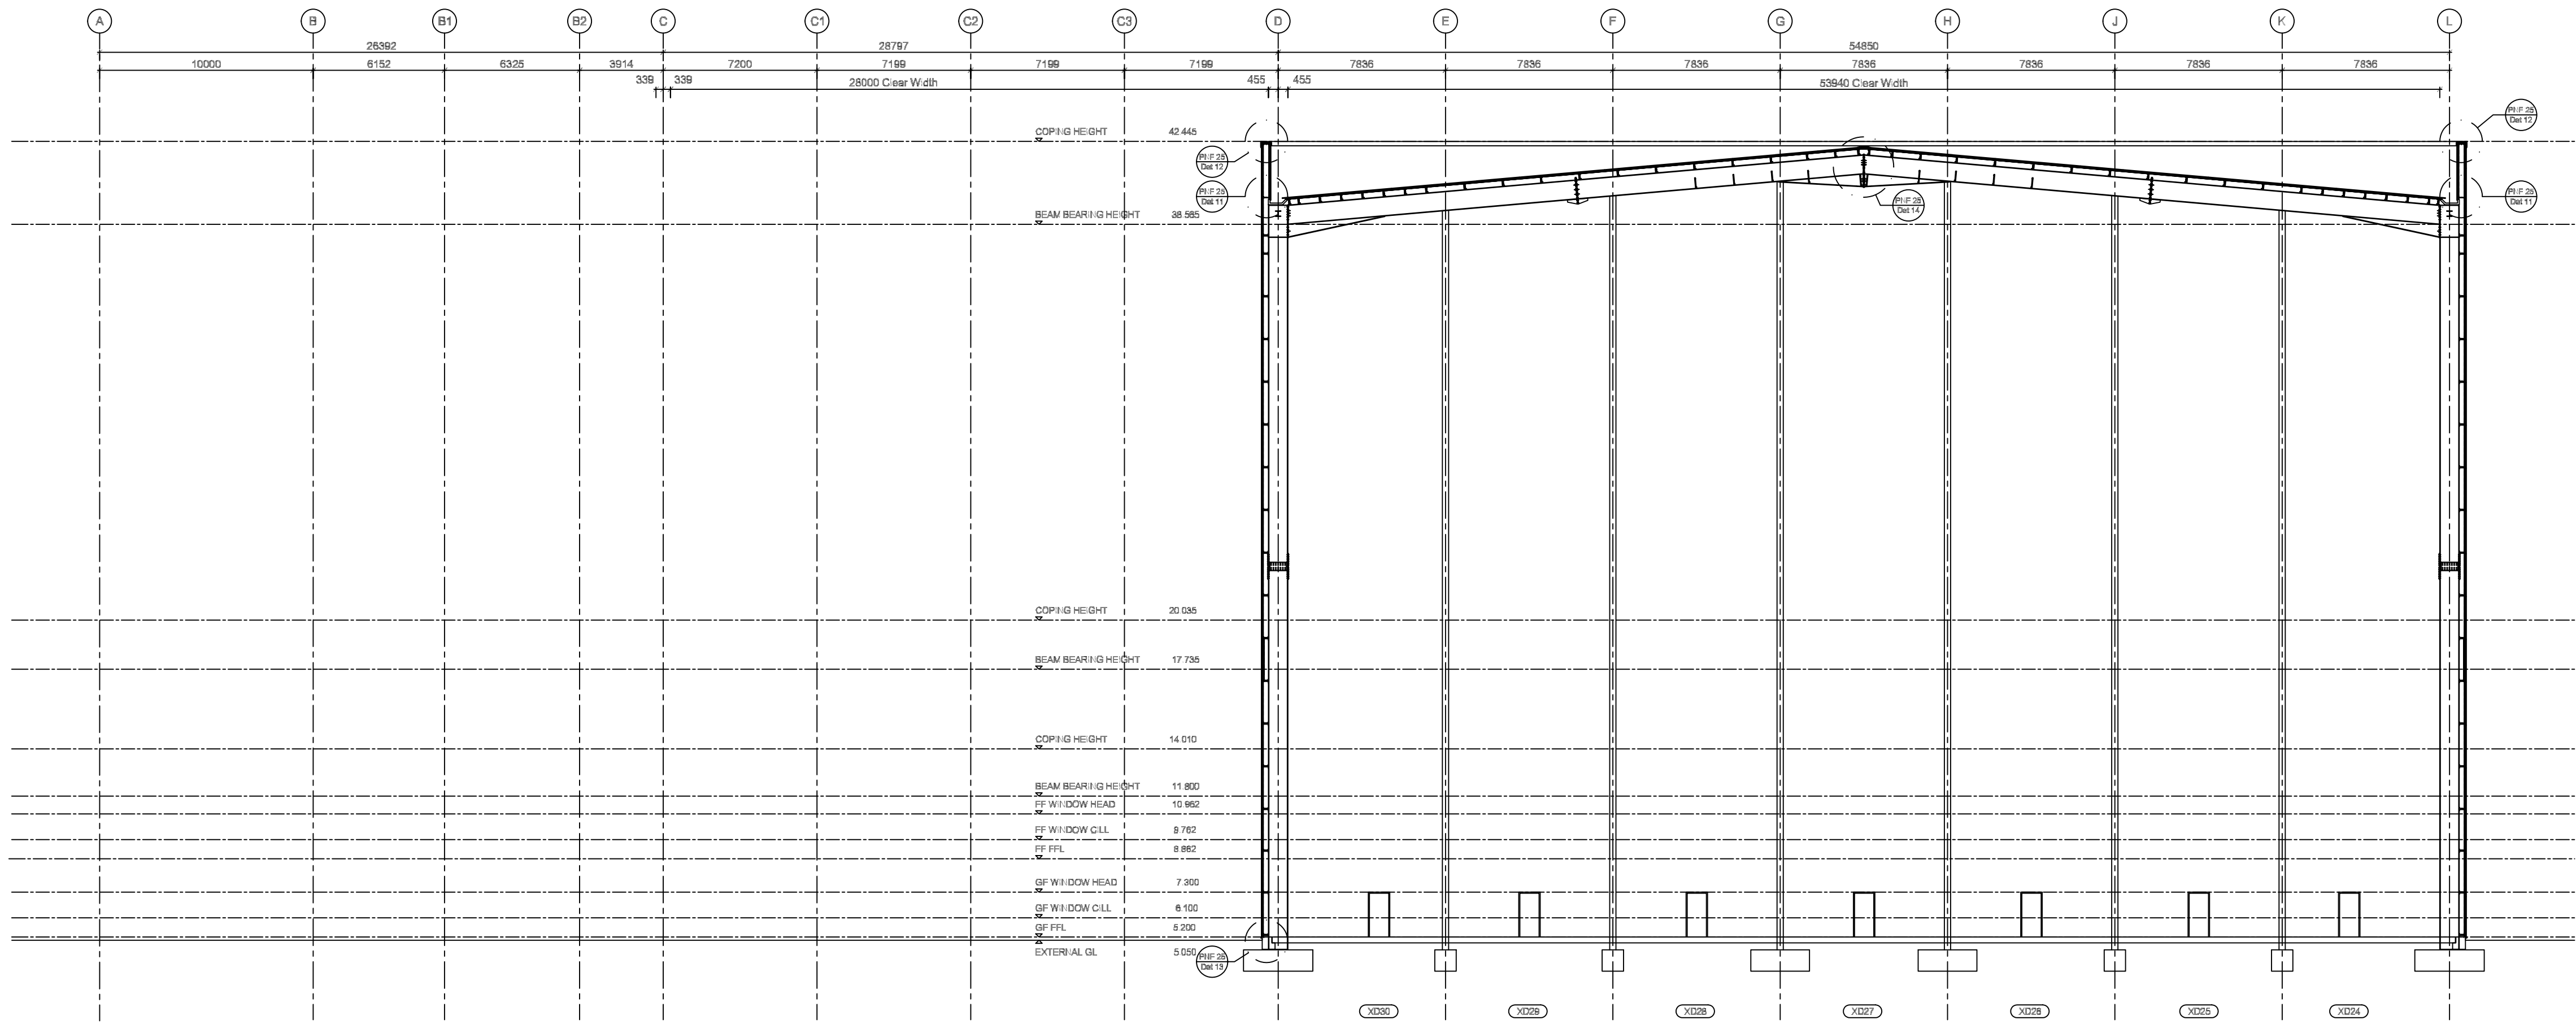

SECTION B-B. Scale 1:200

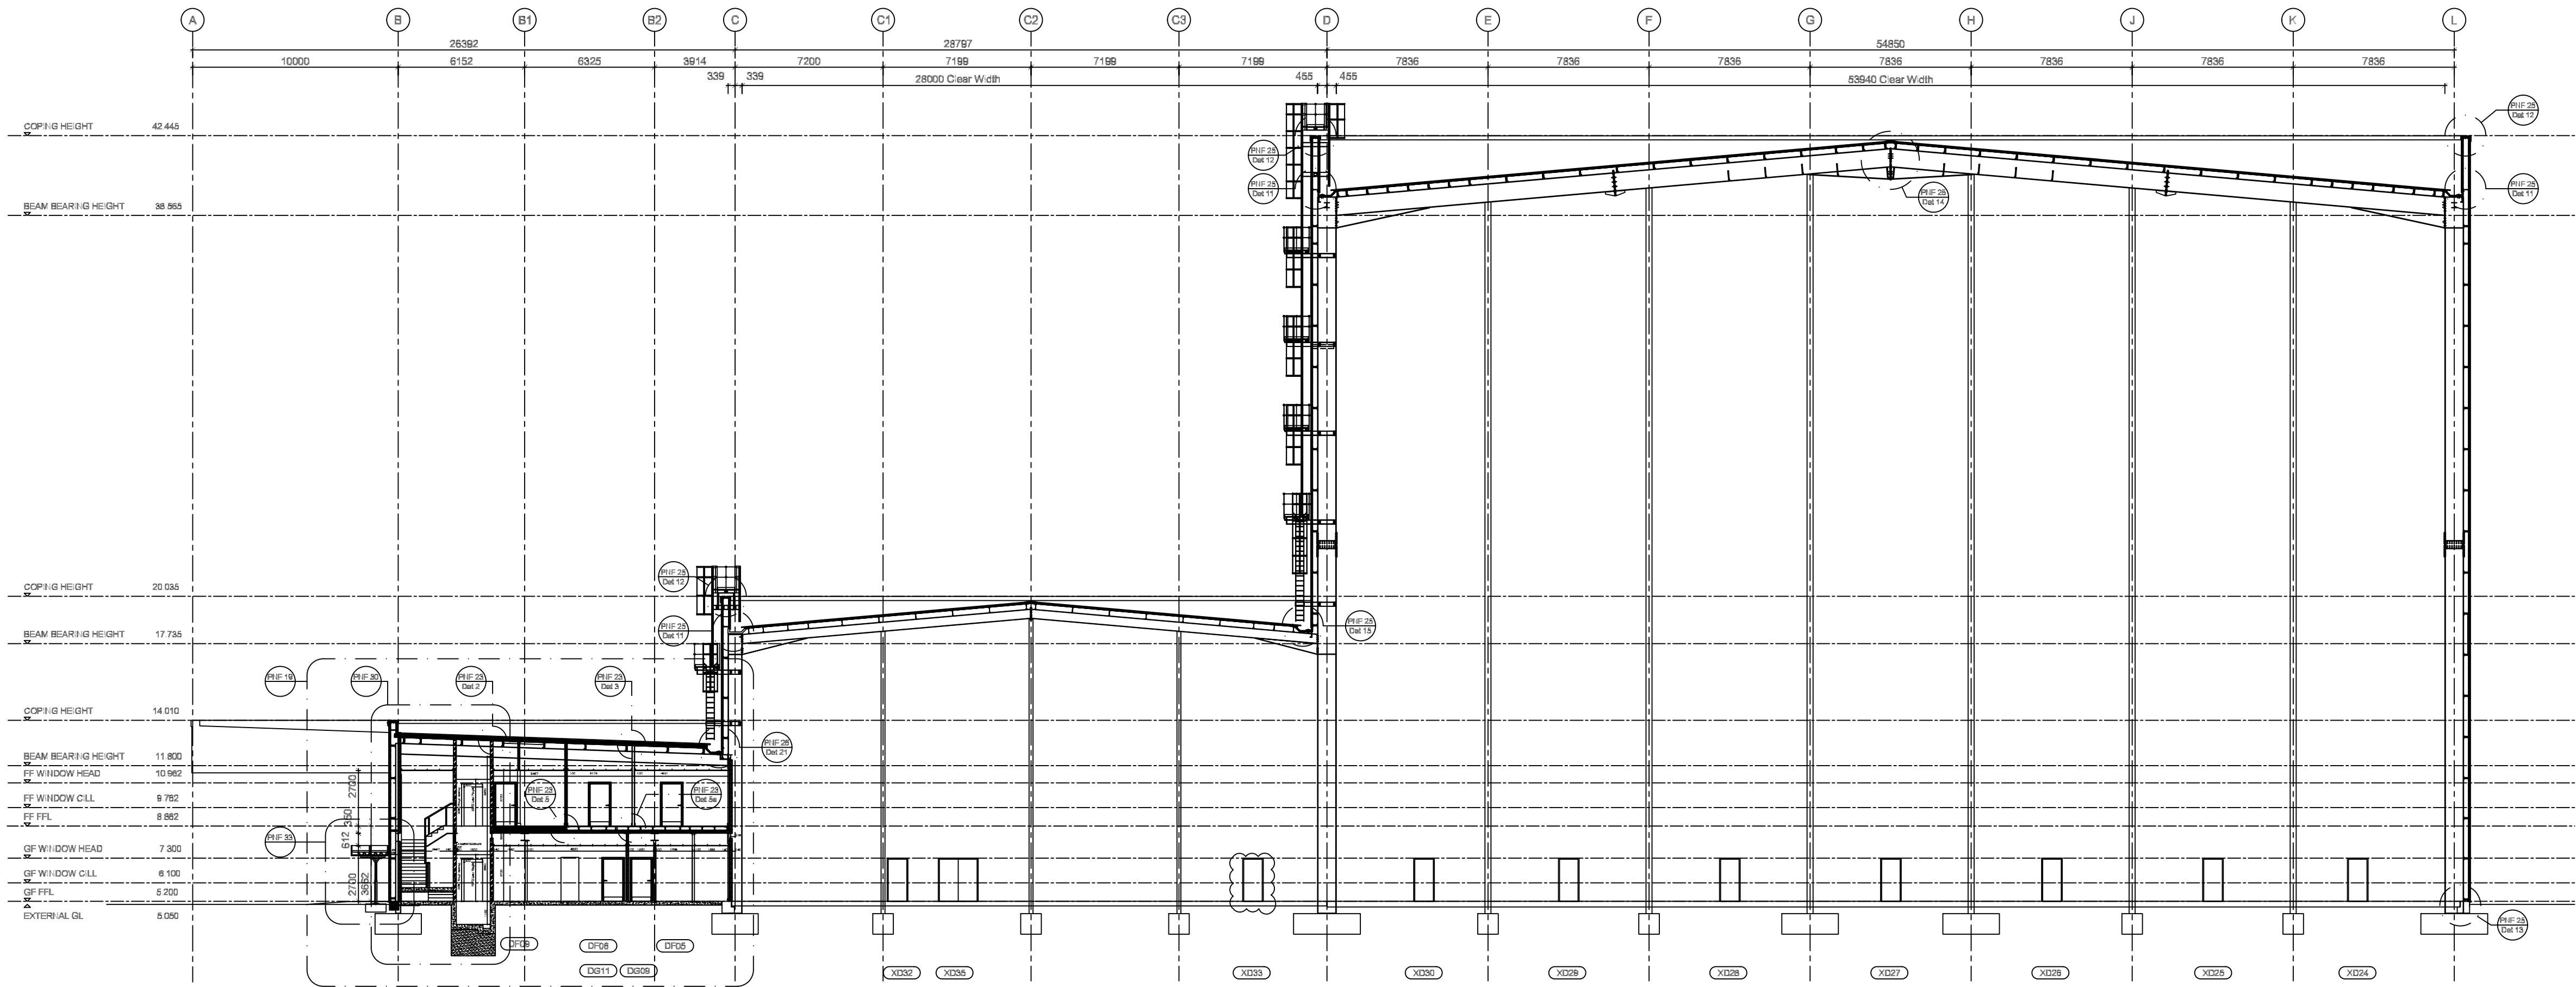

GENERAL NOTES
- DO NOT SCALE
- THIS DRAWING IS TO BE READ IN CONJUNCTION WITH ALL
RELEVANT ENGINEERING AND SERVICES DRAWINGS
SPECIFICATIONS
- ANY DISCREPANCIES / QUERIES TO BE REPORTED BEFORE
WORK IS EXECUTED
- IF IN DOUBT - ASK

© NO PART OF THIS DRAWING MAY BE REPRODUCED, STORED
IN A RETRIEVAL SYSTEM OR TRANSMITTED IN ANY FORM BY ANY
MEANS, ELECTRONIC, MECHANICAL, PHOTOCOPYING,
RECORDING OR OTHERWISE WITHOUT THE WRITTEN
PERMISSION OF THE COPYRIGHT OWNER.

REVIS/ONS
14.04.05 A Section Heights Revised
02.06.05 B New Door XD 33 and Door & Window refs added
04.07.05 C Refs added - issued for Construction
22.11.05 D issued as record drawing

RECORD DRAWING

Bowmer & Kirkland

MOSSCROP ASSOCIATES
URBAN DESIGN - ARCHITECTURE - INTERIORS
Warren Bank House, Simpson, Milton Keynes, MK16 3AQ
Tel: 01908 690266 • Fax: 01908 690544
E-mail: Architecture@MossdropAssociates.co.uk

PROJECT	KIMBERLY CLARK, PHOENIX PROJECT, NORTHFLEET		
TITLE	GENERAL ARRANGEMENT SECTION	DRAWING NO.	REV
DATE	SCALE	PNF 15	D
04.04.05	1:200 @ A1		