
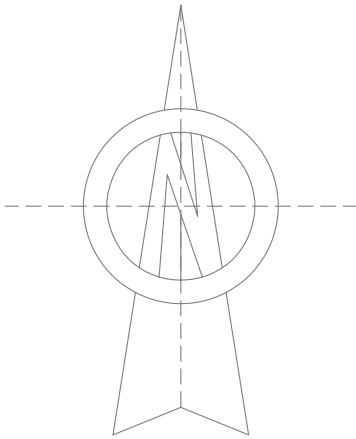


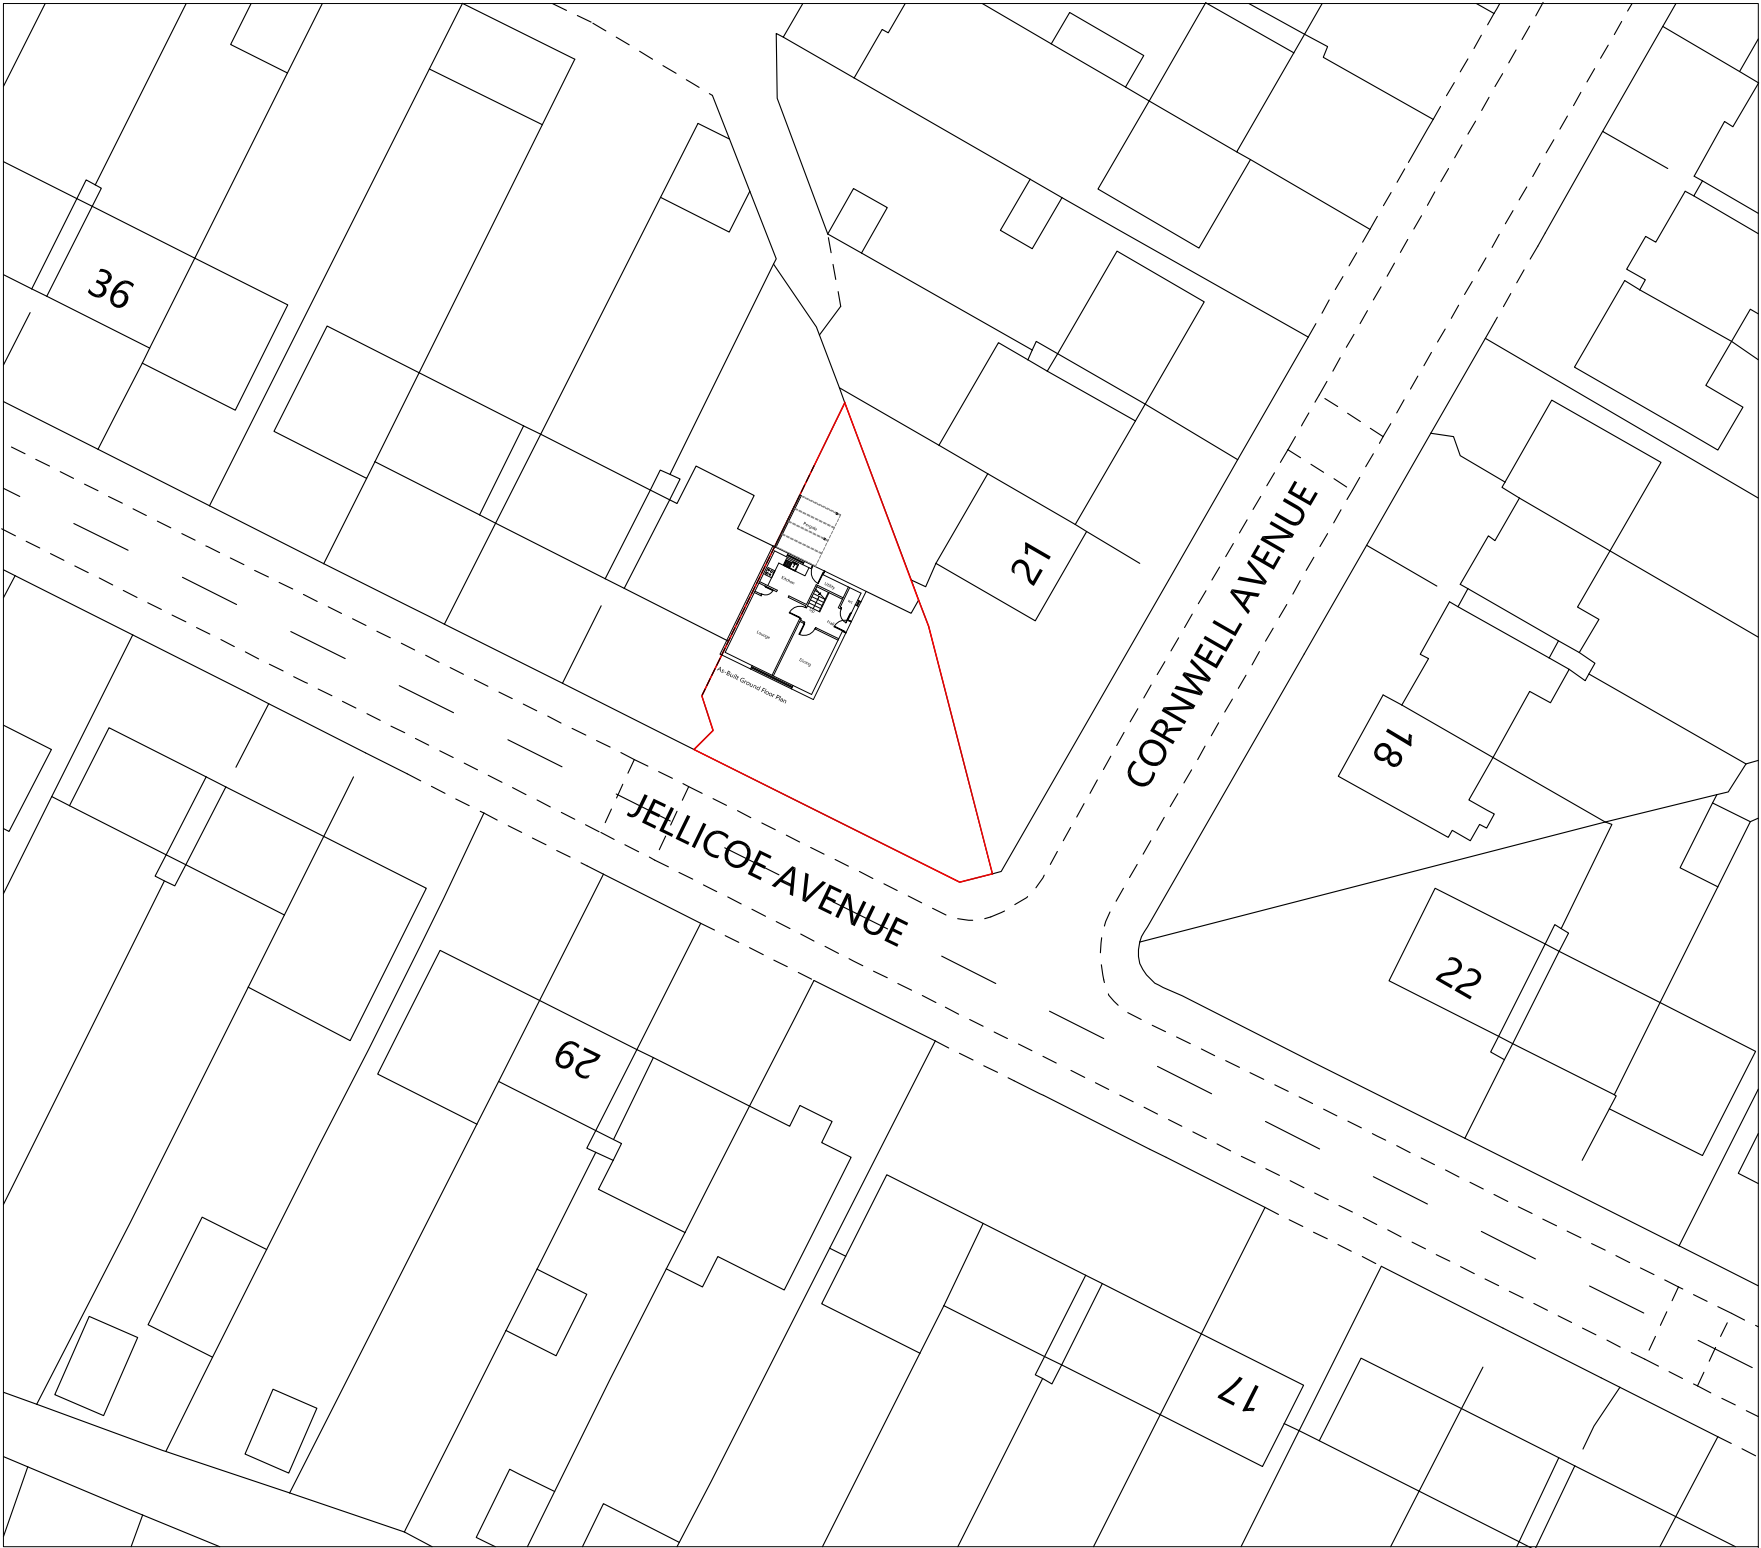

Project 24 JELlicOE AVENUE GRAVESEND DA12 5HT	
Drawing AS-BUILT SITE PLAN	
Dwg No. 106	Date AUGUST 2023
Scale @ A3 1:500	