



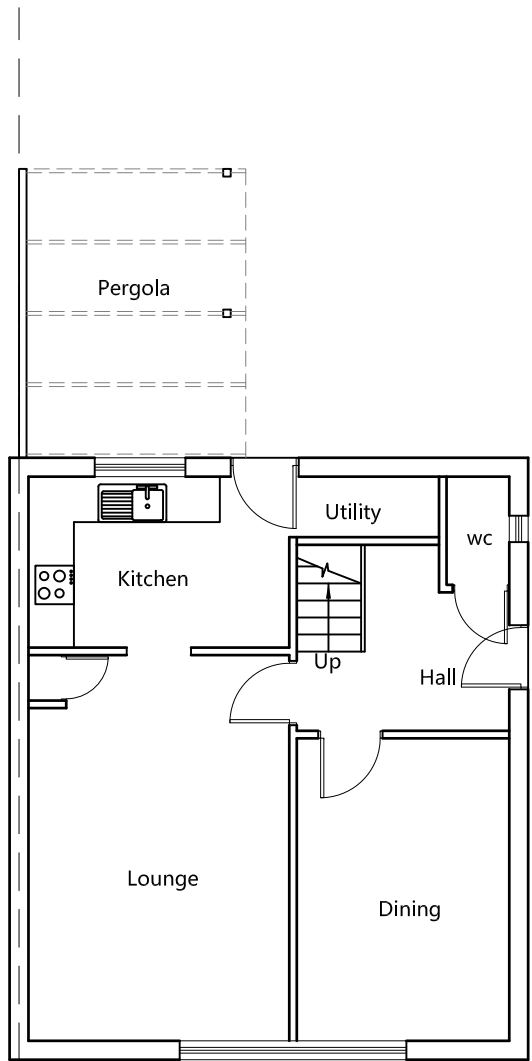

As-Built Ground Floor Plan

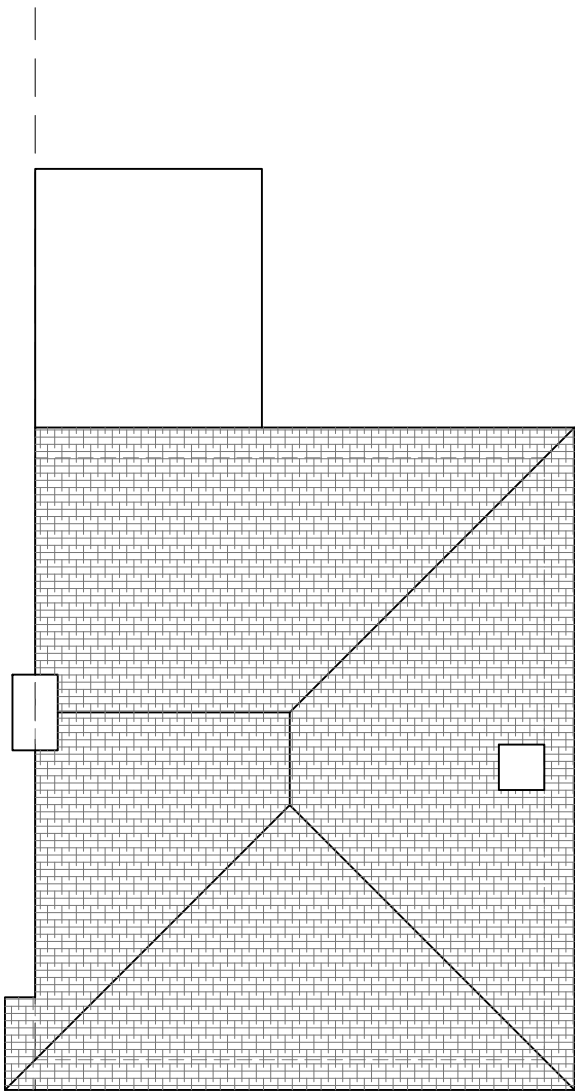

As-Built Roof Plan

Project 24 JELICOE AVENUE GRAVESEND DA12 5HT	
Drawing AS-BUILT PLANS	
Dwg No. 103	Date AUGUST 2023
Scale @ A3 1:100	