





As-Built Front Elevation



As-Built Side Elevation

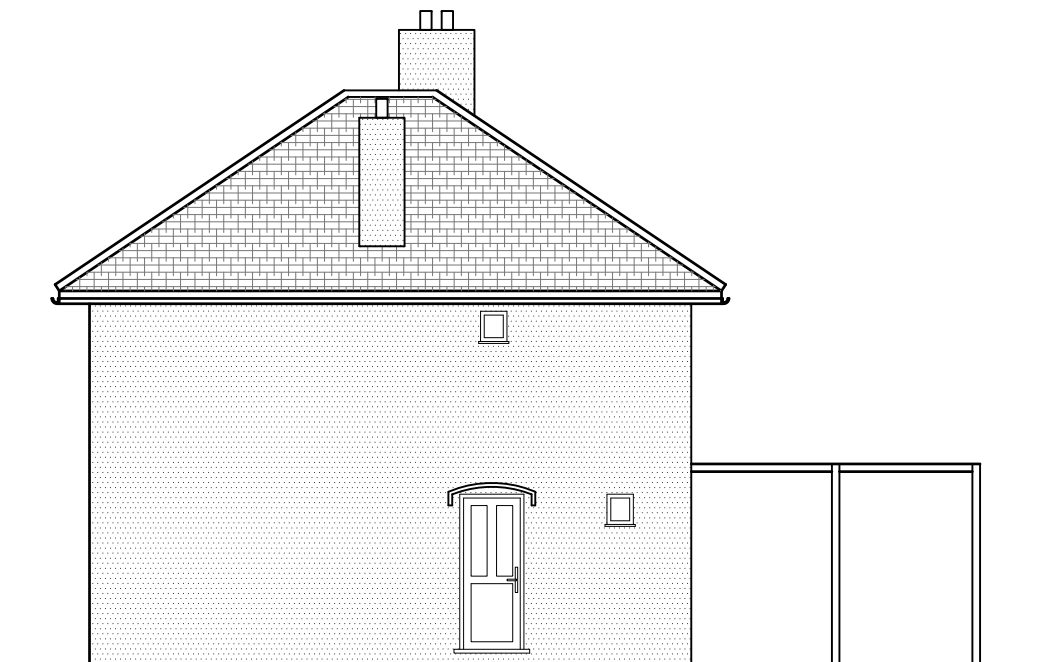

As-Built Rear Elevation

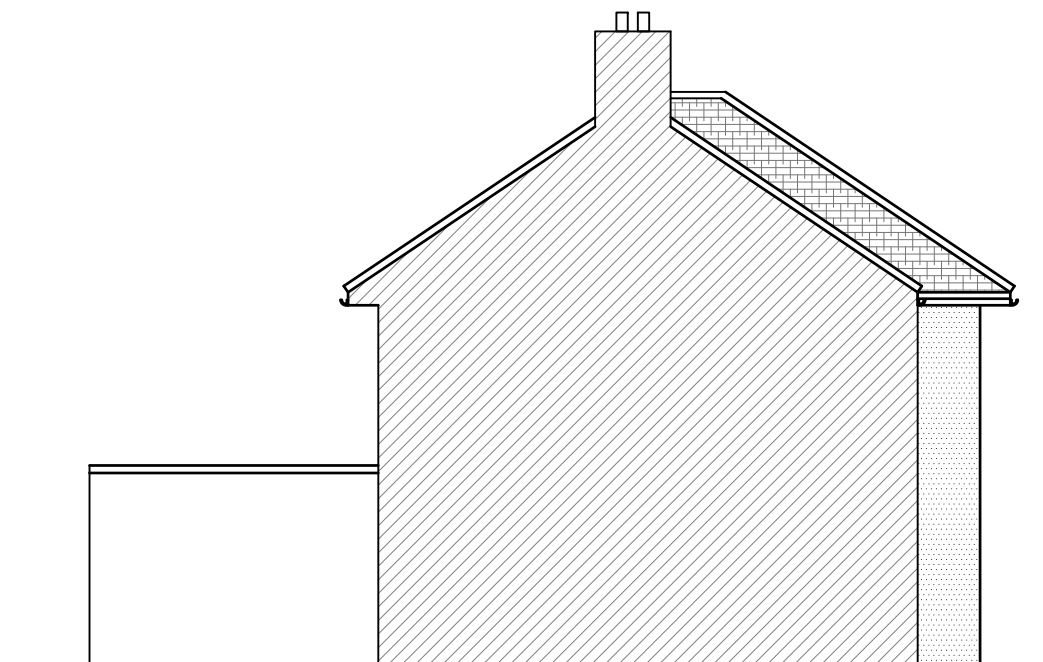

As-Built Side Elevation

Project 24 JELICOE AVENUE GRAVESEND DA12 5HT	
Drawing AS-BUILT ELEVATIONS	
Dwg No. 104	Date AUGUST 2023
Scale @ A3 1:100	
A graphical scale bar with markings for 0, 1, 2, and 3 metres. The text 'METRES' is placed between the 0 and 1 markings.	