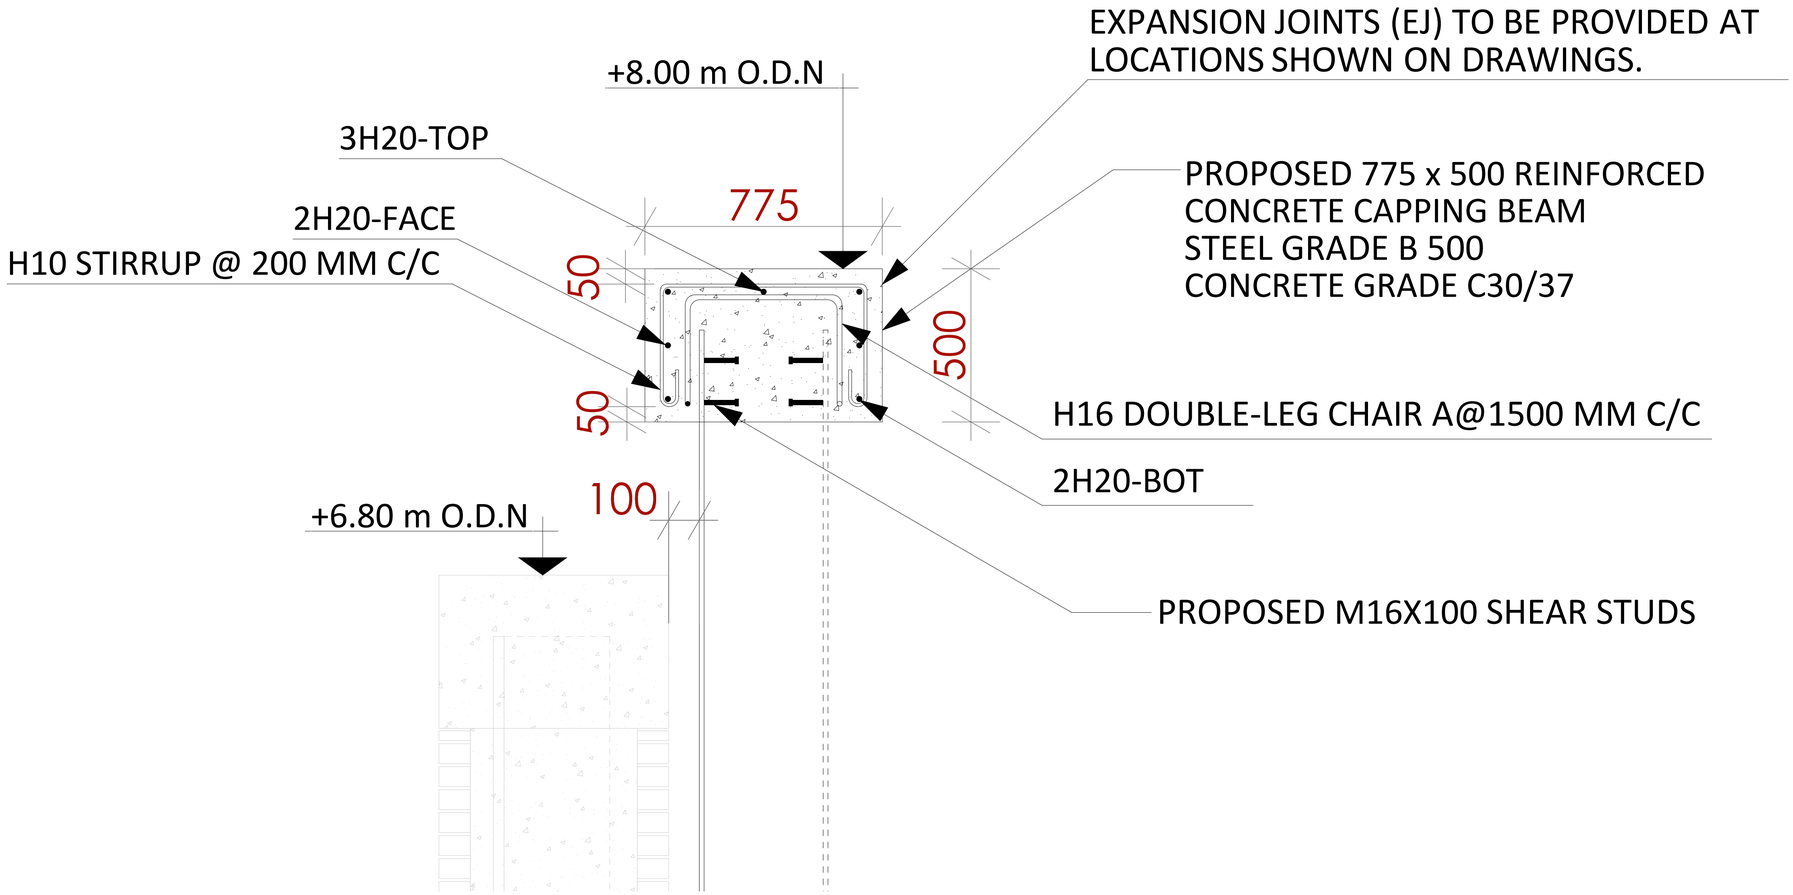

CONCRETE CAPPING BEAM REINFORCEMENT DETAILS - SECTION VIEW 1:10

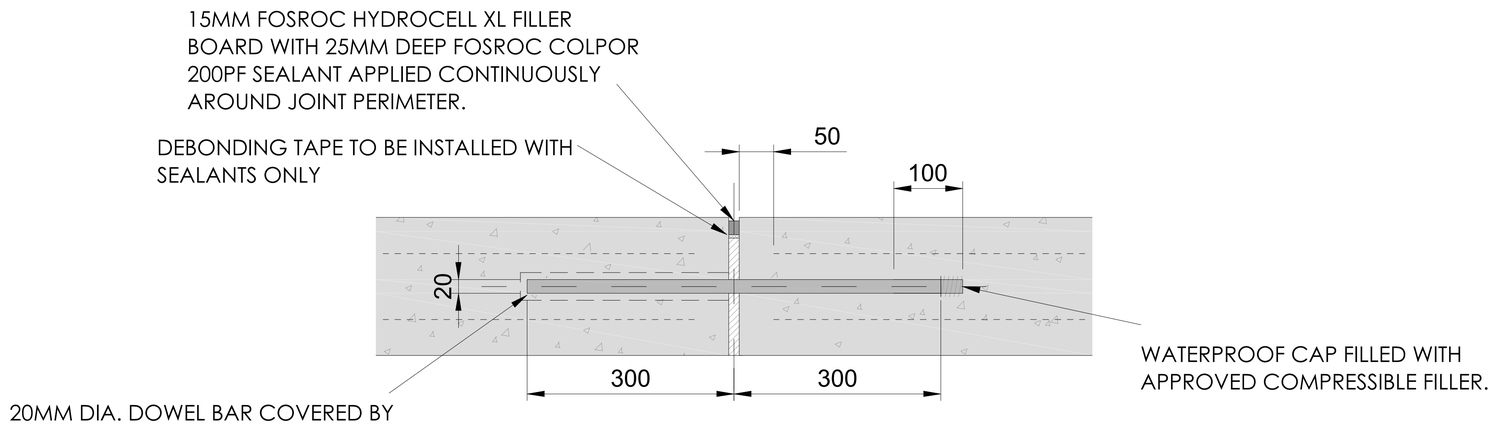

TYPICAL EXPANSION JOINT DETAIL - (EJ)

As Built
13/03/2026
Per provided Statement by DDS

Adkins Consultants Ltd
Surveying, Structural Engineering & Quantity Surveying for the Construction Industry

cabe chartered association of building engineers · RICS Regulated by RICS · CIOB THE CHARTERED INSTITUTE OF BUILDING

Construction Risks	Maintenance/cleaning Risks	Demolition/adaptation Risks

In addition to the hazard/risks normally associated with the types of work detailed on this drawing take note of the above. It is assumed that all works on this drawing will be carried out by a competent contractor working, where appropriate, to an appropriate method statement.

Safety Health and Environmental Information Box

Notes:

This document and its design content are copyright ©. It shall be read in conjunction with all other associated project information including models, specifications, schedules, and related consultants documents. Do not scale from documents. All dimensions are to be checked on site. Immediately report any discrepancies, errors, or omissions on this document to the Originator. Adkins accepts no liability for the accuracy of the survey and proposed layout information supplied by others. If in doubt, ASK.

RevID	Layout Comment	Issue Date	Issuer-Initls	Approved by
C02	FOR CONSTRUCTION	08/07/2025		MBM
C01	FOR CONSTRUCTION	30/06/2025		MBM

Scales @ A1	Issuing Office	Project No.
1:10	Kent	0524SD4169

Client Approval

- A - Approved
- B - Approved with Comments
- C - Do Not Use

Status	Purpose of Issue
S4	FOR CONSTRUCTION

Originator
Adkins Consultants Ltd
130 Ashford Rd, Bearsted, Maidstone ME14 4AF

Project
CUSTOM HOUSE
THE TERRACE
GRAVESEND, DA12 2BW

Layout Title
CONCRETE CAPPING BEAM REINFORCEMENT DETAILS-SECTION

Client
Mile Property Group Ltd

Drawing Number

project	originator	volume	level	type	role	number	rev
CH	AA	XX	XX	DS	E	0501	C02