
A1

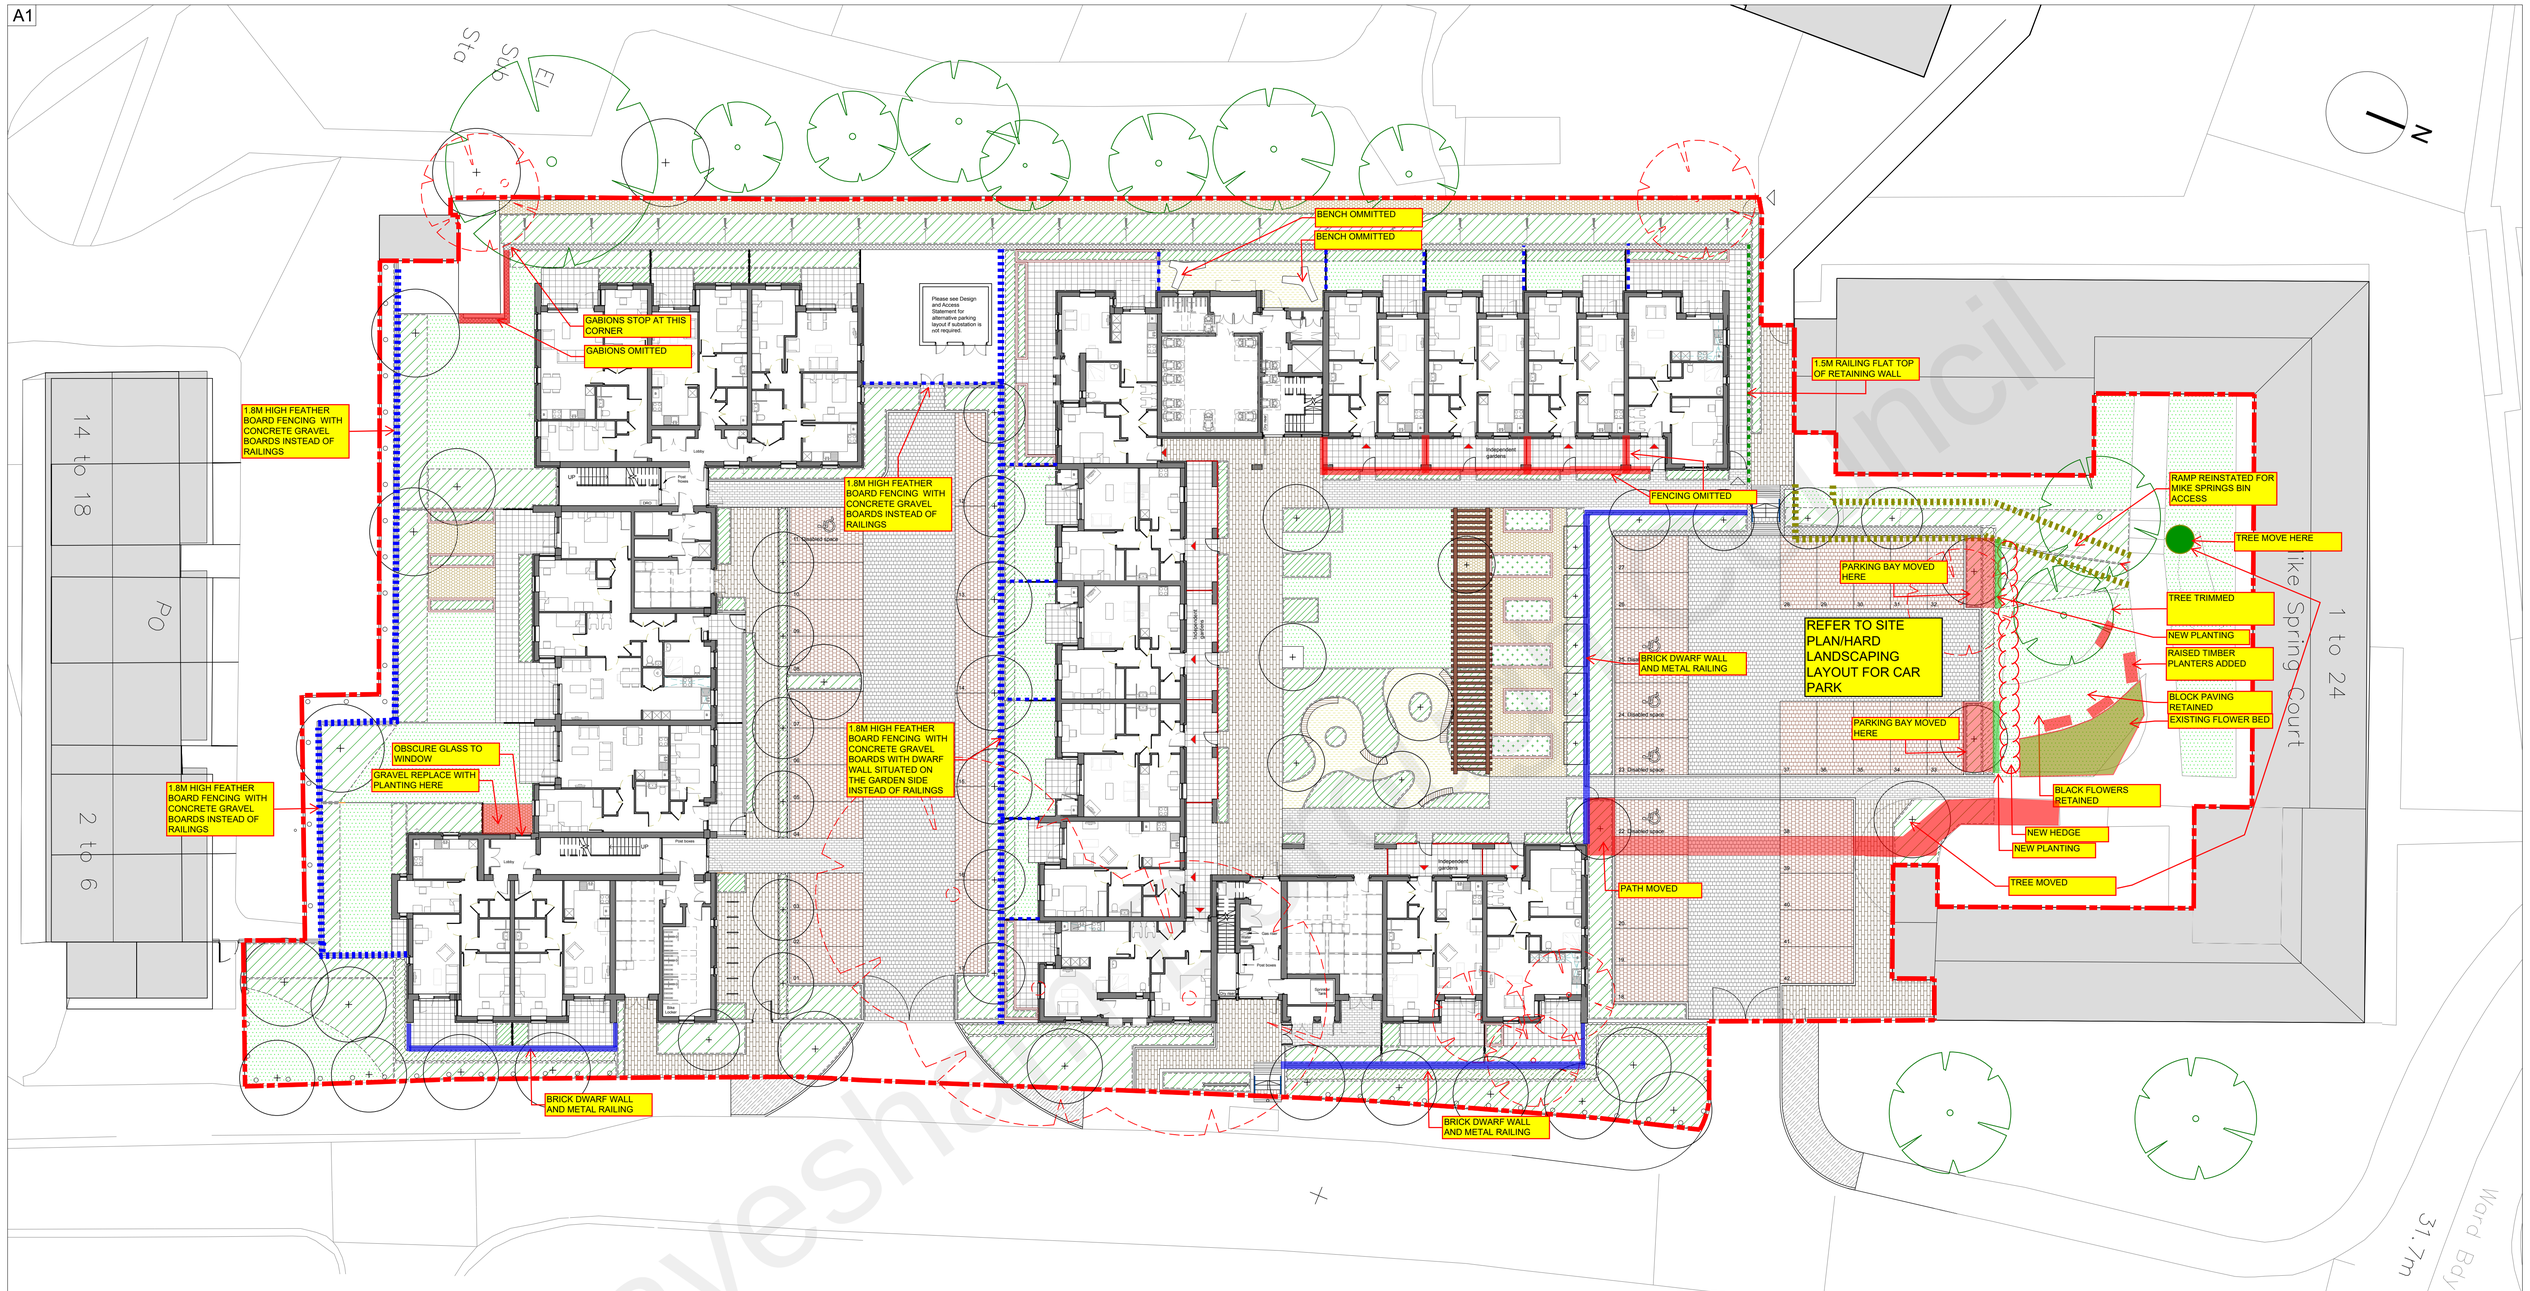

HARD MATERIALS

PRE-CAST CONCRETE PAVING FLAGS - TO PATIOS
'Conversation' textured finish flags; size: 400x400x50mm thickness; colour: Silver Grey; Manufacturer: Marshalls (www.marshalls.co.uk) or equivalent approved

PRE-CAST CONCRETE UNITS
'Modal' blocks; 300x200x80mm thickness; colour: Silver Grey Granite Textured; Manufacturer: Marshalls (www.marshalls.co.uk) or equivalent approved

PRE-CAST CONCRETE LINEAR PAVING
'Modal' 600x200x80mm thickness; colour: Mig grey Granite Textured; Manufacturer: Marshalls (www.marshalls.co.uk) or equivalent approved

PRE-CAST CONCRETE UNITS
'Modal' blocks; 300x200x80mm thickness; colour: Mid Grey Granite Textured; Manufacturer: Marshalls (www.marshalls.co.uk) or equivalent approved

PRE-CAST CONCRETE LINEAR PAVING
'Modal' 600x200x80mm thickness; colour: Indian Granite Textured; Manufacturer: Marshalls (www.marshalls.co.uk) or equivalent approved

RESIN-BOUND GRAVEL — GREY
'Addaset' 5mm; colour: Autumn Gold
Manufacturer: Addagrip (www.addagrip.co.uk) or equivalent approved

POROUS SELF BINDING GRAVEL
CEDEC Gold Footpath Gravel, 50mm compacter layer (initial 65mm Non-compacted layer) Supplier: CED South East, 728 London Road, West Thurrock, Grays, Essex RM0 3LU; www.ced.ltd.uk - or equivalent approved

STREET FURNITURE

CONCRETE 'FLOR' BENCH SEATING (2 No.)
Escofet 'FLOR pequena'; colour: beige; Ref: ES-SE-00350
Manufacturer: Escofet (www.marshalls.co.uk) or equivalent approved

'SHEFFIELD' CYCLE HOOPS
Stainless steel 'Sheffield' - type hoops; Product Code: SHE 688; Finish: G304 satin polished stainless steel; root fixed; Manufacturer: Furnitubes (www.furnitubes.co.uk) or equivalent approved

STEP UNITS
'Conservation' step units, with visibility strip to riser and tread; colour: Silver Grey; Manufacturer: Marshalls (www.marshalls.co.uk) or equivalent approved

ARBOUR
Hardwood arbour - TBC

RAISED TIMBER PLANTERS
Softwood raised planters. Height and length varies

TIMBER BOLLARDS
Refer to Architect's specification

EDGING AND HANDRAILS

CONCRETE KERB - TO CAR PARK
British Standard Kerb pre-cast concrete kerb, Half Battered; Size 125 x 255 x 914mm; www.marshalls.co.uk - or equivalent approved.
Refer to Engineer's specification.

HANDRAILS TO STEPS & RAMPS
Flat rolled steel handrail

FENCELINE
Refer to Architect's specification

FEATHER EDGE BOARD

1.5M RAILING FLAT TOP OF RETAINING WALL

SOFTWORKS

SHRUB & GROUNDCOVER PLANTING

HEDGELINES

PROPOSED LAWN
'Medallion' turf
Supplier: Rolawn (www.rolawn.co.uk) or equivalent approved

PROPOSED 'GROW YOUR OWN'
With raised timber sleeper planters

EXISTING TREES - TO BE RETAINED

EXISTING TREES - TO BE REMOVED

PROPOSED TREES

SITE BOUNDARY

LANDSCAPE MARKUP SHOWING CHANGES AGREED BY WESTRIDGE WITH GRAVESHAM COUNCIL 03.04.2022

METRES 1:200
0 1 2 4 6 8 10 20m

Revisions

Rev	Date	Description
A	21.01.2019	Raised planters added to wheelchair units
B	01.02.2019	Frontage to Valley Drive amended. Issued for planning
C	14.02.2019	Scale bar added to drawing
D	28.02.2019	Issued for Stage 3

49 Canonbie Road, London SE23 3AQ
07971 699 601 info@me-landscape.com
ME Landscape Studio

Project	Valley Drive	Client	Gravesham B.C
Drawing	Landscape Masterplan	Status	Stage 3
Drawing No.	0145_100	Scale	1:200@A1
Project No.	0145 Drawn EL Checked ML	Date	20.12.2018 Rev D

Gravesham