

© This drawing is protected by copyright and must not be copied or reproduced without the written consent of Penfold Project Services

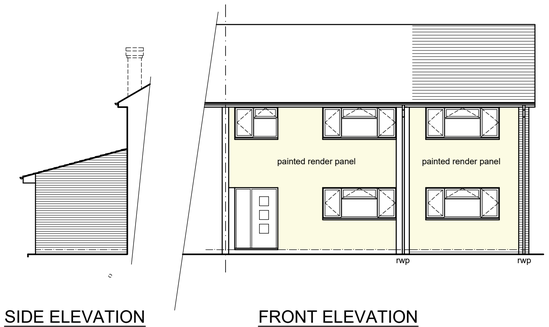

SIDE ELEVATION
(1:100)

FRONT ELEVATION
(1:100)

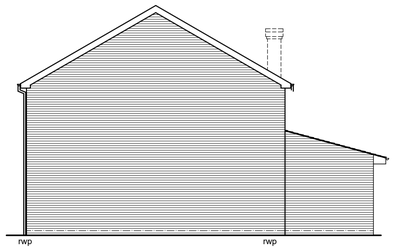


SIDE ELEVATION
(1:100)



REAR ELEVATION
(1:100)

MATERIALS

ROOF - ROOF TILES TO MATCH EXISTING
WALLS - FACING BRICK TO MATCH EXISTING
RENDERED PANELS TO FRONT ELEVATION
WINDOWS - WHITE uPVC TO MATCH EXISTING
DOORS - WHITE uPVC TO MATCH EXISTING
HARDSTANDING - BLOCK PAVING ON PERMEABLE SUB-BASE

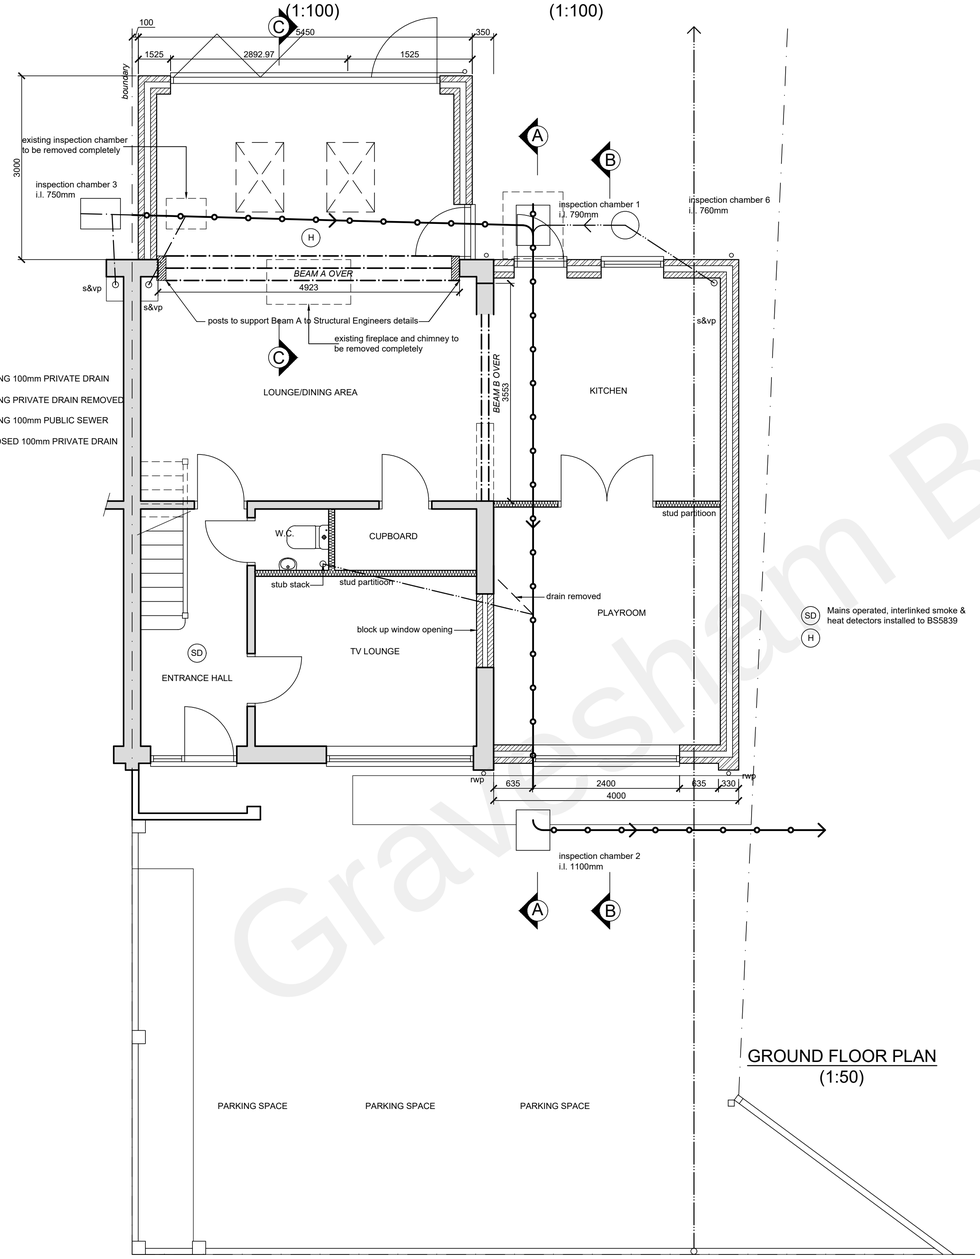

GROUND FLOOR PLAN
(1:50)

DRAINAGE LEGEND

- EXISTING 100mm PRIVATE DRAIN
- EXISTING PRIVATE DRAIN REMOVED
- EXISTING 100mm PUBLIC SEWER
- PROPOSED 100mm PRIVATE DRAIN

FIRST FLOOR PLAN
(1:50)

METRES 0 5
SCALE

SCALE BAR @ 1:100

METRES 0 1 2
SCALE

SCALE BAR @ 1:50

Date	No	Revision
20/06/22	D	Side extension altered to as built footprint Rendered panel to front elevation added
07/08/20	C	Heat detector added to kitchen
26/07/20	B	Beam A & support details altered
25/06/20	A	Construction notes added

Penfold Project Services
Epmarket, Wrotham Road, Meopham, Kent, DA13 0JH
Telephone: 01474 816690
e-mail: apenfold448@btinternet.com

Job Title: 8 BYCLIFFE TERRACE
GRAVESNED
KENT
DA11 0JD

Dwg Title: PLANS & ELEVATIONS
AS PROPOSED

Scale: 1:50 & 1:100 @ A1

Dwg No.: 102D

Date: March 2020

Gravesham Borough Council