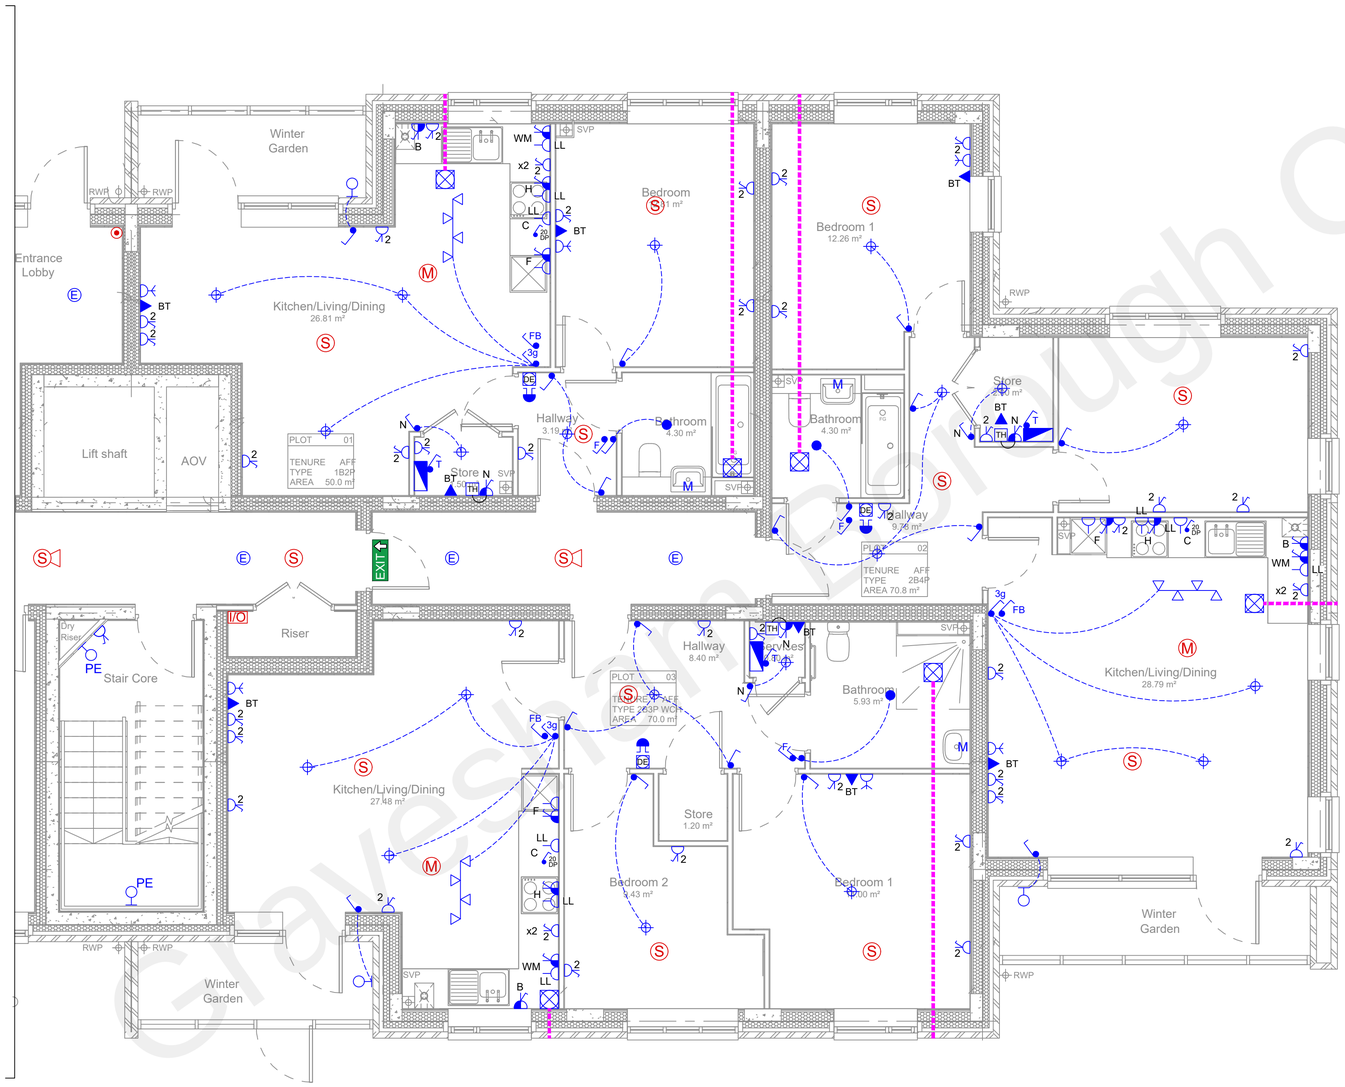


Scale 1:50

0 1 2 3 4 5 10

ELECTRICAL SERVICES	
	IP65 21w LED 1200mm surface mounted from OVIA Lingar U-Lite range
E	As above, with emergency pack
(E)	Circular surface mounted 18w LED with corridor arrow + emergency from OVIA Inceptor range
PE	Circular surface mounted 18w LED with eyelid cover, IP65 rated + PIR & emergency from OVIA Inceptor
	Circular IP54 bulkhead + LED lamp from OVIA Barra range
	White pendant fitting 150mm + LED lamp
	Circular IP44 LED 9w
	Chrome 4bar spot light + LED lamps
EXIT	Exit sign
M	Mirror light.
	Single gang rocker switch. 'N' denotes neon.
2g 3g	2 & 3 gang rocker light switch.
(P)	PIR sensor
DE	Door entry hand set
	Door bell
	Unswitched single socket outlet
	Single switched socket
2	Twin switched socket outlet
	Switched fused spur. 'N' denotes neon.
BT	Secondary telephone outlet
	TV outlet
M	Combined heat & carbon monoxide detector
S	Smoke detector
C	Carbon monoxide detector
	Manual call point
I/O	Interface
S	Smoke detector c/w sounder
FAP	Fire alarm panel
F	Fan isolator switch
FB	Neon fan booster switch
	Greenwood Airvac Unity CV2GIP extract fan
	PVC rigid ducting 204 x 60mm
T	Test switch
SI	Sprinkler interface
	Consumer unit
20 DP	20A double pole switch
TH	Tubular heater

- THIS DOCUMENT IS COPYRIGHT OF THE ORIGINATOR AND MUST BE TREATED AS CONFIDENTIAL.
- THIS DOCUMENT MUST NOT BE ALTERED, REPRODUCED OR DISTRIBUTED WITHOUT PRIOR WRITTEN CONSENT OF THE ORIGINATOR.
- DO NOT SCALE THIS DOCUMENT. ALL DIMENSIONS MUST BE CHECKED ON SITE PRIOR TO COMMENCEMENT OF ANY RELATED WORKS.
- THIS DOCUMENT MUST BE READ IN CONJUNCTION WITH ALL SUPPORTING DOCUMENTS PRODUCED BY THE ORIGINATOR.
- USERS OF THIS DOCUMENT ARE RESPONSIBLE FOR CHECKING WHICH REVISION IS CURRENT.

Notes & Symbols:

Fixing Heights:

- General purpose sockets, telephone & TV outlets 450mm FFL to bottom.
- Outlets above worktops 150mm FFL to bottom.
- Light switches & door entry 1200mm FFL to bottom.
- Consumer units 1500mm FFL to bottom.
- Lamp holders 2100mm FFL.

Abbreviations:

C - Cooker

F - Fridge

H - Hob

B - Boiler

WM - Washing machine

LL - Low level

N - neon

Rev.	Date.	Description.

jwskent
ELECTRICAL CONTRACTORS
www.jwskent.com

Unit 11, Palace Industrial Estate, Bircholt Road, Maidstone, Kent, ME15 9XU
Tel: 01622 688334 Email: enquiries@jwskent.com

Project:
ST. PATRICK'S GARDEN

Drawing Title:
GROUND FLOOR
ELECTRICAL SERVICES
SHEET 2 OF 2

Scale:	Date:
1:50@A1	27/09/21

Drawing Status:
AS INSTALLED

Drawing No. ST PATRICK'S/02

Revision:

Gravesham Borough Council