


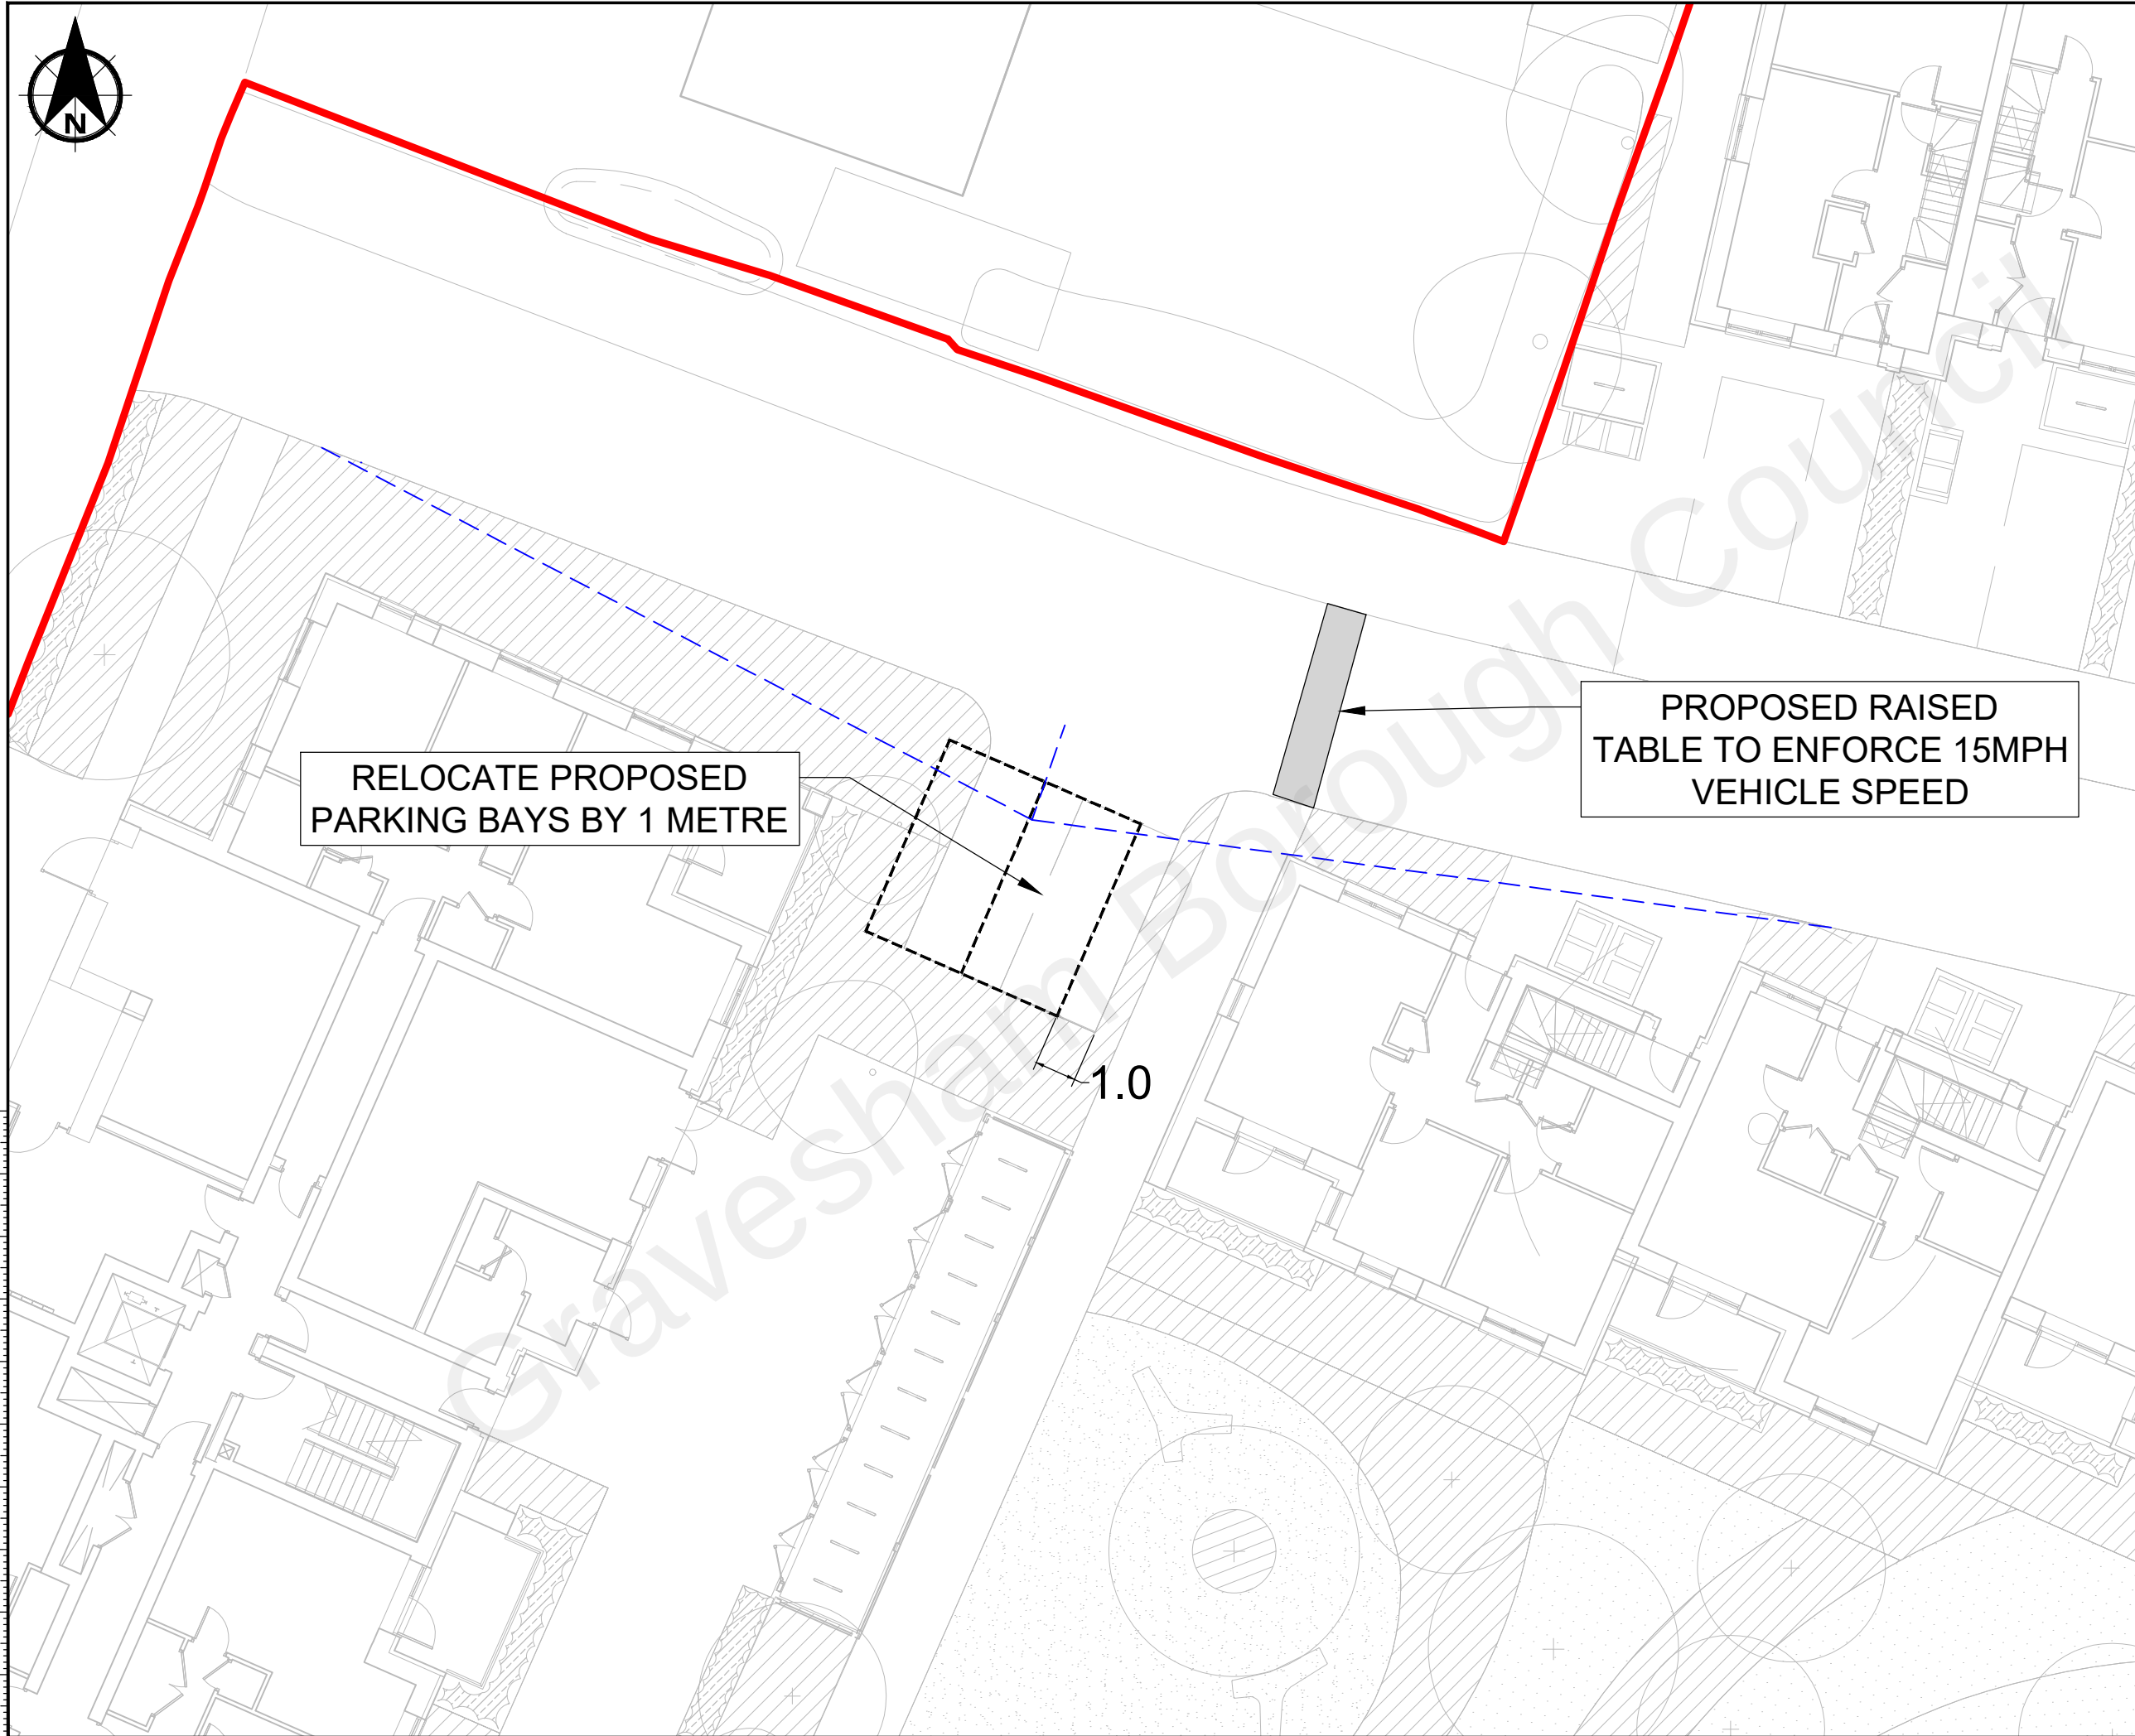

RELOCATE PROPOSED
PARKING BAYS BY 1 METRE

PROPOSED RAISED
TABLE TO ENFORCE 15MPH
VEHICLE SPEED

- NOTES
- DO NOT SCALE FROM THIS DRAWING MANUALLY OR ELECTRONICALLY.
 - THIS DRAWING IS TO BE READ IN CONJUNCTION WITH ALL OTHER RELEVANT PROJECT INFORMATION.
 - ALL DATUM LEVELS ARE IN METRES AND DIMENSIONS ARE IN METRES UNLESS OTHERWISE STATED.

KEY:

--- = 2.4m x 19m
VISIBILITY SPLAYS
FOR 15MPH
VEHICLE SPEED

— = SITE RED LINE
BOUNDARY

P01		14.12.2022	FIRST ISSUE		BK	TM	TM
Rev	Date		Amendment Details		Dr'n	Chk'	App'
This drawing should not be relied on or used in circumstances other than those for which it was originally prepared and for which Sweco UK Limited was commissioned. Sweco UK Limited accepts no responsibility for this drawing to any party other than the person by whom it was commissioned. Any party which breaches the provisions of this disclaimer shall indemnify Sweco UK Limited for all loss or damage arising therefrom. COPYRIGHT © Sweco 2022							
3rd Floor, Eldon House 2 Eldon Street London EC2M 7LS Tel: +44 (0)20 3002 1210 Web: www.sweco.co.uk					SWECO		
Client							
GRAVESHAM BOROUGH COUNCIL							
Project Title							
ST COLUMBA'S CLOSE, GRAVESEND							
Drawing Title							
PARKING VISIBILITY SPLAYS & SPEED CONTROL MEASURES							
Purpose Of Issue							
PRELIMINARY							
Status		Status Description					
S0		INITIAL STATUS OR WIP					
Drawn		Designed		Checked		Approved	
BK		BK		TM		TM	
Sheet Size		Scale		Sweco Ref		Revision	
A3		1:150		65203358		P01	
Drawing Number							
65203358-SWE-XX-XX-DR-TP-0004							